

CARD MUST BE TYPED

State of Kansas
NOTICE OF INTENTION TO DRILL

CARD MUST BE SIGNED

(see rules on reverse side)

Starting Date: Dec. 15 1984
month day year

API Number 15- 185-22, 140-0060

OPERATOR: License # 9963

S.E. 1/4 Sec 28.. Twp 23.. S, Rge 12.. East West
(location)

Name CRUDE RECOVERY CORPORATION

Address 555 N. Woodlawn, Bldg. 1, Suite 207

City/State/Zip Wichita, KS 67208

Contact Person Vern Brungardt

Phone 681-3601

1800' Ft North from Southeast Corner of Section

4050' Ft West from Southeast Corner of Section

(Note: Locate well on Section Plat on reverse side)

CONTRACTOR: License # 4049

Name Dynasty Drilling Corp.

City/State Wichita, KS

Nearest lease or unit boundary line 840' feet.

County Stafford

Lease Name Hager Well# 1

Domestic well within 330 feet: yes no

Municipal well within one mile: yes no

Well Drilled For: Well Class: Type Equipment:

- Oil Swd Infield Mud Rotary
- Gas Inj Pool Ext. Air Rotary
- OWWO Expl Wildcat Cable

Depth to Bottom of fresh water 110 feet

Lowest usable water formation Top Permian

Depth to Bottom of usable water 250 feet

Surface pipe by Alternate: 1 2

Surface pipe to be set 250 feet

Conductor pipe if any required feet

Ground surface elevation feet MSL

This Authorization Expires 6-10-85

Approved By 12-10-84

If OWWO: old well info as follows:

Operator

Well Name

Comp Date Old Total Depth

Projected Total Depth 3900 feet

Projected Formation at TD Arbuckle

Expected Producing Formations Arbuckle

I certify that we will comply with K.S.A. 55-101, et seq., plus eventually plugging hole to K.C.C. specifications.

Date 12-7-84 Signature of Operator or Agent

Vern Brungardt

Title Manager

MHC/NOHE 12/10/84 Form C-1 4/84

Must be filed with the K.C.C. five (5) days prior to commencing well
This card void if drilling not started within six (6) months of date received by K.C.C.

CONSERVATION DIVISION
Wichita, Kansas


DEC 10 1984

12-10-84

Important procedures to follow:

RECEIVED
STATE CORPORATION COMMISSION
Wichita, Kansas
1 Mile

A Regular Section of Land

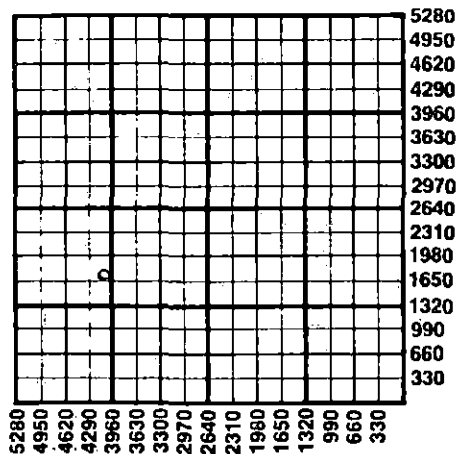

1. Notify District office before setting surface casing.
2. Set surface casing by circulating cement to the top.
3. File completion forms ACO-1 with K.C.C. within 90 days of well completion, following instructions on ACO-1, side 1, and including copies of wireline logs.
4. Notify District office 48 hours prior to old well workover or re-entry.
5. Prior to plugging, prepare a plugging plan, then obtain agreement from the appropriate district office for an approved plugging plan.
6. Submit plugging report (CP-4) to K.C.C. after plugging is completed.
7. Obtain an approved injection docket number before disposing of salt water.
8. Notify K.C.C. within 10 days when injection commences or terminates.
9. If an alternate 2 completion, cement in the production pipe from below any usable water to surface within 120 days of spud date.

State Corporation Commission of Kansas
Conservation Division
200 Colorado Derby Building
Wichita, Kansas 67202
(316) 263-3238