


STATE OF KANSAS
STATE CORPORATION COMMISSION

WELL PLUGGING RECORD

Give All Information Completely
Make Required Affidavit
Mail or Deliver Report to:
Conservation Division
State Corporation Commission
211 No. Broadway
Wichita, Kansas

NORTH

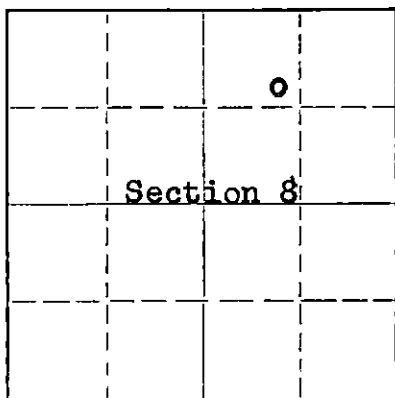

Locate well correctly on above
Section Plat

Stafford County. Sec. 8 Twp. 22 Rge. 14 (W W) (W)
Location as "NE/CNW&SW&" or footage from lines SE NW NE
Lease Owner Petroleum, Inc.
Lease Name Strobel "D" Well No. 1
Office Address Route 2, Great Bend, Kansas
Character of Well (completed as Oil, Gas or Dry Hole) Dry hole
Date well completed August 12 19 58
Application for plugging filed August 12 19 58
Application for plugging approved August 12 19 58
Plugging commenced August 12 19 58
Plugging completed August 12 19 58
Reason for abandonment of well or producing formation No producible zones

If a producing well is abandoned, date of last production None 19
Was permission obtained from the Conservation Division or its agents before plugging was commenced? Yes

Name of Conservation Agent who supervised plugging of this well Frank Broadfoot
Producing formation ----- Depth to top ----- Bottom ----- Total Depth of Well 3915 Feet
Show depth and thickness of all water, oil and gas formations.

OIL, GAS OR WATER RECORDS

CASING RECORD

FORMATION	CONTENT	FROM	TO	SIZE	PUT IN	PULLED OUT
				8 5/8"	225'	None

Describe in detail the manner in which the well was plugged, indicating where the mud fluid was placed and the method or methods used in introducing it into the hole. If cement or other plugs were used, state the character of same and depth placed, from feet to feet for each plug set.

Mud up with heavy mud to 210' followed by a wooden plug and 1/3 sack hulls. Placed 20 sacks cement through drill pipe on to plug. Mud up to 35' followed by a wooden plug and 1/4 sack hulls. Filled hole with 10 sacks cement to base of well cellar.

(If additional description is necessary, use BACK of this sheet)

Name of Plugging Contractor Farvey Drilling Co.
Address Route 2, Great Bend, Kansas

STATE OF Kansas COUNTY OF Barton, ss.
Don Searle (employee of owner) or (~~owner~~) of the above-described

well, being first duly sworn on oath, says: That I have knowledge of the facts, statements, and matters herein contained and the log of the above-described well as filed and that the same are true and correct. So help me God.

(Signature) Don Searle

Route 2, Great Bend, Kansas
(Address)

SUBSCRIBED AND SWORN TO before me this 26th day of August, 19 58

My commission expires July 11, 1960

[Signature]
Notary Public.
8-28-58
AUG 28 1958
CONSERVATION DIVISION
Wichita, Kansas

PLUGGING
FILE SEC. 8 T. 22 R. 14W
BOOK PAGE 122 LINE 19

WELL LOG

15-185.00225-0000

COMPANY Petroleum, Inc.

SEC. 8 T. 22S R. 11W

FARM STROBEL "D" NO. 1


LOC. SE NW NE

TOTAL DEPTH 3915'

COUNTY Stafford

COMM. August 4, 1958 COMP. August 11, 1958

CONTRACTOR Garvey Drilling Company

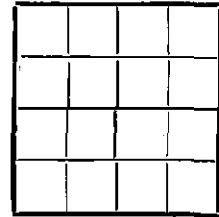

CASING 8-5/8" @ 225' w/200 sax

ELEVATION 1949' DF

PRODUCTION Plugged & Abandoned

FIGURES INDICATE BOTTOM OF FORMATIONS

200	Sand & Shale
325	Shale w/Sand Streaks
400	Shale
575	Sand
878	Red Bed
915	Anhydrite
1910	Shale & Shells
2340	Lime & Shale
2565	Shale & Shells
2915	Shale & Lime
3325	Lime & Shale
3465	Shale & Lime
3805	Lime
3839	Chert
3890	Cherty Lime
3915	Arbuckle

RTD 3915'

PLUGGING
 FILE SEC. 8 T. 22 R. 11W
 BOOK PAGE 122 LINE 19

RECEIVED
 CORPORATION COMMISSION
 AUG 28 1958
 CONSERVATION DIVISION
 Wichita, Kansas

State of KANSAS }
 County of BARTON } ss:

I, Verne A. Morris of Garvey Drilling Company

upon oath state that the above and foregoing is a true and correct copy of the log of the STROBEL "D" #1 well

Subscribed and sworn to before me this 25th day of August 19 58

My Commission Expires: July 11, 1960

Verne A. Morris

Ed J. Bauer
 NOTARY PUBLIC