


STATE OF KANSAS  
STATE CORPORATION COMMISSION

WELL PLUGGING RECORD

Give All Information Completely  
Make Required Affidavit  
Mail or Deliver Report to:  
Conservation Division  
State Corporation Commission  
211 No. Broadway  
Wichita, Kansas

Stafford County. Sec. 8 Twp. 22 Rge. (E) 14 (W)  
Location as "NE/CNW/SW" or footage from lines NW/SW/NE  
Lease Owner Natural Gas & Oil  
Lease Name Harry Strobel Well No. 2  
Office Address Route #1, Great Bend, Kansas  
Character of Well (completed as Oil, Gas or Dry Hole)  
Date well completed 19  
Application for plugging filed 19  
Application for plugging approved 19  
Plugging commenced 5-4 1956  
Plugging completed 5-10 1956  
Reason for abandonment of well or producing formation

NORTH

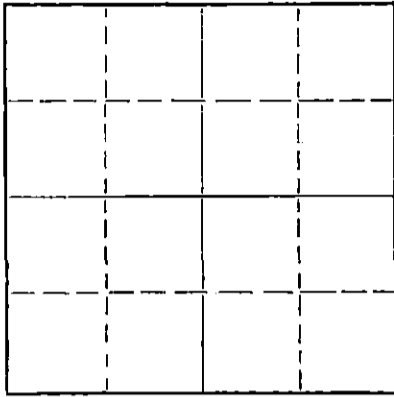

Locate well correctly on above  
Section Plat

If a producing well is abandoned, date of last production 19  
Was permission obtained from the Conservation Division or its agents before plugging was commenced? yes

Name of Conservation Agent who supervised plugging of this well Brundage  
Producing formation Depth to top Bottom Total Depth of Well 3927 Feet  
Show depth and thickness of all water, oil and gas formations.

OIL, GAS OR WATER RECORDS

CASING RECORD

FORMATION	CONTENT	FROM	TO	SIZE	PUT IN	PULLED OUT
				5 1/2"		3377.74

Describe in detail the manner in which the well was plugged, indicating where the mud fluid was placed and the method or methods used in introducing it into the hole. If cement or other plugs were used, state the character of same and depth placed, from feet to feet for each plug set.

Plugging started 5-4-1956 and completed 5-10-1956. Measured in to T D 3927'.  
Plugged off bottom with 30' of rock and dumped in 5 sacks of cement. Worked pipe. Shot at 3518', 3360'. Circulated. Spotted 70 bbls. oil. Mixed 20 sacks of heavy mud and 2 sacks of hulls with 90 sacks of cement; pumped in under pressure to shut off water.

(If additional description is necessary, use BACK of this sheet)

Name of Plugging Contractor J. O. Forbes, d/b/a/ Forbes Casing Pulling Company  
Address Box 221, Great Bend, Kansas

STATE OF Kansas COUNTY OF Barton, ss.  
J. O. Forbes (employee of owner) or (owner or operator) of the above-described well, being first duly sworn on oath, says: That I have knowledge of the facts, statements, and matters herein contained and the log of the above-described well as filed and that the same are true and correct. So help me God.

(Signature) J. O. Forbes  
(Address) Box 221 G.B.

SUBSCRIBED AND SWORN TO before me this 12 day of May, 1956

My commission expires April 8, 1957

Notary Public. RECEIVED STATE CORPORATION COMMISSION

PLUGGING  
FILE SEC 8 T 22 R 14W  
BOOK PAGE 54 LINE 2

MAY 14 1956 5-14-56  
CONSERVATION DIVISION  
Wichita, Kansas


WELL LOG BUREAU—KANSAS GEOLOGICAL SOCIETY  
508 East Murdock, Wichita, Kansas

Company- WESTGATE-GREENLAND OIL CO.  
Farm- Harry Strobel No. 2

SEC. 8 T. 22 R. 14W  
NW SW NE

Total Depth. 3927  
Comm. 11-11-52 Comp. 12-5-52  
Shot or Treated.  
Contractor. Westgate Drilling Corporation  
Issued. 1-24-53

County Stafford  
KANSAS

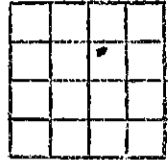

Elevation. 1953 DF

Production. 25 bbls.

Figures indicate Bottom of Formations.

sand & clay	205
shale & shells	335
sand	410
shale & shells	875
anhydrite	910
shale & shells	1075
red bed & shells	1230
shale, salt & shells	1460
shale & shells	1510
lime	1520
shale & shells	1660
shale w/ lime	1700
shale & lime	1740
lime	1855
shale & lime	1945
lime	2013
shale & lime	3225
lime	3245
lime & shale	3467
lime	3714
lime, shale & chert	3828
shale	3860
shale & sand	3878
Arbuckle lime	3927
Total Depth	

TOPS:	
Anhydrite	875
Heebner	3342
Brown lime	3462
Lansing	3473
Base KC	3703
Viola	3770
Simpson	3824
Arbuckle	3874

DST #1: 3874-79 open 1 hr. 60'  
heavily oil cut mud. BHP 980#

DST #2: 3879-89 open 1 hr. 180' gas  
120' heavily oil & gas cut mud.  
420' gassy oil. BHP 1200# FFP 220#  
Schlumberger run.

Perf. 23 holes, 3902-10 filled up 1200' wtr.  
in 1 hrs. Lane-Wells plug @ 3894 $\frac{1}{2}$ , perf.  
69 holes 3871-88, swb.  $\frac{1}{2}$  BOPH natural,  
1000 gals. acid. Swb. 15 BOPH, no wtr.  
12-6-52, filed 25 BOPD Temp. Prod. Affidavit.

RECEIVED  
STATE OF KANSAS COMMISSION

APR 10 1953

CONSERVATION DIVISION  
Wichita, Kansas

