


Give All information Completely
Make Required Affidavit
Mail or Deliver Report to:
Conservation Division
State Corporation Commission
212 No. Market
Wichita, Kansas

WELL PLUGGING RECORD

Stafford County, Sec. 11 Twp. 22S Rge. (E) 14 (W)

Location as "NE/CNW/SW" or footage from lines NW NE SW
Lease Owner John C. Graves, et al
Lease Name Brining Well No. 1
Office Address 505 Union Center, Wichita, Kansas
Character of Well (completed as Oil, Gas or Dry Hole) Dry Hole
Date well completed November 30, 19 66
Application for plugging filed November 30, 19 66
Application for plugging approved November 30, 19 66
Plugging commenced November 30, 19 66
Plugging completed November 30, 19 66
Reason for abandonment of well or producing formation

NORTH

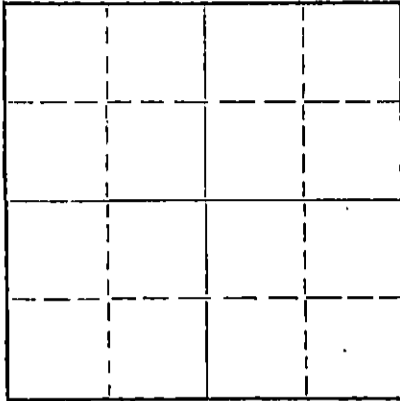

Locate well correctly on above
Section Plat

If a producing well is abandoned, date of last production 19
Was permission obtained from the Conservation Division or its agents before plugging was commenced? Yes

Name of Conservation Agent who supervised plugging of this well A. Elving, Pratt, Kansas
Producing formation Depth to top Bottom Total Depth of Well Feet
Show depth and thickness of all water, oil and gas formations.

OIL, GAS OR WATER RECORDS

CASING RECORD

FORMATION	CONTENT	FROM	TO	SIZE	PUT IN	PULLED OUT
				8-5/8"	233'	None

Describe in detail the manner in which the well was plugged, indicating where the mud fluid was placed and the method or methods used in introducing it into the hole. If cement or other plugs were used, state the character of same and depth placed, from feet to feet for each plug set.

Mudded up with heavy mud to 230 feet. Followed by wooden plug and 1/2 sack hulls. Placed 25 sacks cement onto hulls. Mudded up with heavy mud to 40 feet followed by wooden plug, 1/2 sack hulls and 10 sacks cement to base of well cellar. Plugged rat hole with 2 sacks cement.

RECEIVED
NOV 19 1966
CONS. DIVISION
12-19-66

(If additional description is necessary, use BACK of this sheet)
Name of Plugging Contractor Graves Drilling Co., Inc.
Address 505 Union Center, Wichita, Kansas 67202

STATE OF KANSAS, COUNTY OF BUTLER, ss.
John C. Graves (employee of owner) or (owner or operator) of the above-described

well, being first duly sworn on oath, says: That I have knowledge of the facts, statements, and matters herein contained and the log of the above-described well as filed and that the same are true and correct. So help me God.

(Signature) John C. Graves
505 Union Center, Wichita, Kansas 67202
(Address)

SUBSCRIBED AND SWORN to before me this 15th day of December, 19 66

My commission expires April 30, 1967

Betty Brandt
Notary Public.

R O T A R Y D R I L L E R S ' L O G

OPERATOR: John C. Graves, et al DRILLING COMMENCED: November 22, 1966
 505 Union Center
 Wichita, Kansas

CONTRACTOR: Graves Drilling Co., Inc. DRILLING COMPLETED: November 30, 1966
 505 Union Center
 Wichita, Kansas

CASING RECORD: 8 Jts. 233' 8-5/8" LOCATION: Brining No. 1
 cemented with 200 sacks NW NE SW
 Section 11-22S-14W
 Stafford County, Kansas

0 - 241 Sand & shale
 241 - 950 Sand & red bed
 950 - 1630 Shale, shells & red bed
 1630 - 2738 Lime & shale
 2738 - 2997 Shale
 2997 - 3255 Lime
 3255 - 3294 Shale & lime
 3294 - 3335 Lime & shale
 3335 - 3413 Shale & sandy sahel
 3413 - 3695 Lime
 3695 - 3740 Lime & shale
 3740 - 3780 Shale & sandy shale
 3780 - 3799 Lime
 3799 Rotary Total Depth

RECEIVED
 STATE CORPORATION COMMISSIONER
 DEC 19 1966
 CONSERVATION DIVISION
 Wichita, Kansas

I hereby certify the foregoing statements to be true and correct to the best of my knowledge.

GRAVES DRILLING CO., INC.

By Phil Graves
 President

STATE OF KANSAS)
) SS:
 BUTLER COUNTY)

Subscribed and sworn to before me, a Notary Public, this 15th of December, 1966.

Betty Brandt
 Betty Brandt Notary Public

My commission expires:
April 30, 1967