

STATE OF KANSAS  
STATE CORPORATION COMMISSION


Form CP-4

Give All Information Completely  
Make Required Affidavit  
Mail or Deliver Report to:  
Conservation Division  
State Corporation Commission  
212 No. Market  
Wichita, Kansas 67202

WELL PLUGGING RECORD

Stafford County. Sec. 11 Twp. 22S Rge. (E) 14 (W)

Location as "NE/CNWxSWx" or footage from lines C E/2 NW SW  
Lease Owner J. A. Allison  
Lease Name Brining Well No. 1  
Office Address 1415 Wichita Plaza - Wichita, Kansas  
Character of Well (completed as Oil, Gas or Dry Hole) dry  
Date well completed 8-21 19 71  
Application for plugging filed 8-21 19 71  
Application for plugging approved 8-21 19 71  
Plugging commenced 12:00 AM 8-21 19 71  
Plugging completed 1:00 AM 8-21 19 71  
Reason for abandonment of well or producing formation

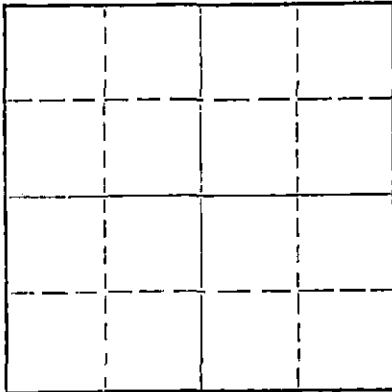

Locate well correctly on above  
Section Plat

If a producing well is abandoned, date of last production 19  
Was permission obtained from the Conservation Division or its agents before plugging was commenced? yes

Name of Conservation Agent who supervised plugging of this well B. Berstien  
Producing formation Depth to top Bottom Total Depth of Well 3794 Feet  
Show depth and thickness of all water, oil and gas formations.

OIL, GAS OR WATER RECORDS

CASING RECORD

FORMATION	CONTENT	FROM	TO	SIZE	PUT IN	PULLED OUT
	326x Sand	0	326	8 5/8"	326	0

Describe in detail the manner in which the well was plugged, indicating where the mud fluid was placed and the method or methods used in introducing it into the hole. If cement or other plugs were used, state the character of same and depth placed, from feet to feet for each plug set.

Plug hole w/40 sx @ 600' 25 Sx @ 300' & 10 sx @ 40'  
2 sx in rat hole By Halliburton

RECEIVED  
STATE CORPORATION COMMISSION  
AUG 25 1971  
CONSERVATION DIVISION  
Wichita, Kansas

(If additional description is necessary, use BACK of this sheet)  
Name of Plugging Contractor B & B Drilling, Inc.  
Address 720 Union Center - Wichita, Kansas

STATE OF Kansas, COUNTY OF Sedgwick, ss.  
Bill Lahar (employee of owner) or (owner or operator) of the above-described well, being first duly sworn on oath, says: That I have knowledge of the facts, statements, and matters herein contained and the log of the above-described well as filed and that the same are true and correct. So help me God.

(Signature) Bill Lahar  
720 Union Center - Wichita, Kansas  
(Address)

SUBSCRIBED AND SWORN TO before me this 24th day of August, 19 71

My commission expires May 31, 1974  
Alma A. Neises Notary Public.

**B & B DRILLING, INC.**

~~207 Petroleum Building~~ 720 UNION CENTER  
Wichita, Kansas 67202

August 24, 1971

DRILLERS LOG

Re: J. A. Allison #1 Brining  
C E/2 NW SW Section 11-22S-14W  
Stafford County, Kansas

OPERATOR: J. A. Allison  
CONTRACTOR: B & B Drilling, Inc.  
COMMENCED: August 11, 1971  
COMPLETED: August 21, 1971  
TOTAL DEPTH: 3794'

Set 326' of 8 5/8" w/275 sx

0	125	Sand
125	330	Surface Hole
330	390	Red Rock
390	830	Red Bed
830	837	Anhydrite
837	1850	Shale
1850	2049	Shale & Lime
2049	2295	Shale
2295	2545	Shale & Lime
2545	3190	Shale & Lime
3190	3330	Lime & Shale
3330	3560	Lime
3560	3690	Lime
3690	3794	Lime
3794		Total Depth

DST - #1 3560 - 3595'  
DST - #2 3591 - 3642'  
DST - #3 3377 - 3794'

D &amp; A

RECEIVED  
STATE CORPORATION COMMISSION  
AUG 25 1971  
CONSERVATION DIVISION  
Wichita, Kansas

We certify the above and foregoing to be true and correct copy of the log on the #1 Brining, located in Stafford County, Kansas.

Bill Lohan President

Olson Q. Neeser Notary Public  
Subscribed and sworn to before me this 24th day  
of August, 1971. My commission expires  
May 31, 1974