

**Give All Information Completely.
Make Required Affidavit
Mail or Deliver Report to:
Conservation Division
State Corporation Commission
800 Bitting Building
Wichita, Kansas**

WELL PLUGGING RECORD

15.185-01065-0000

OR

FORMATION PLUGGING RECORD

Strike out upper line when reporting plugging off formations.

NORTH

Locate well correctly on above
Section Plot

Stafford County, Sec. 11 Twp. 22 Rge. 14 (E) (W)

Location as "NE $\frac{1}{4}$ NW $\frac{1}{4}$ SW $\frac{1}{4}$ " or footage from lines 660 N. Line, 330 East Line

Lease Owner J. M. McMorrow and Others 5E

Lease Name Williams Well No. 1

Office Address.....

Character of Well (completed as Oil, Gas or Dry Hole) Dry Hole

Date, well completed July 11th 1941

Application for plugging filed July 9th 1941

Application for plugging approved July 9th 1941

Plugging Commenced.....	July 9th.....	19 41
-------------------------	---------------	-------

Plugging Completed.....July 10th.....1941

Reason for abandonment of well or producing formation.....**Dry Hole**.....

If a producing well is abandoned, date of last production.....19.....

Was permission obtained from the Conservation Division or its agents before plugging was commenced? Yes

Name of Conservation Agent who supervised plugging of this well.....Alexander Plugger.....

Producing formation..... Depth to top..... Bottom..... Total Depth of Well **3875** Feet

Show depth and thickness of all water, oil and gas formations.

OIL, GAS OR WATER RECORDS

CASING RECORD

[illegible]

Describe in detail the manner in which the well was plugged, indicating where the mud fluid was placed and the method or methods used in introducing it into the hole. If cement or other plugs were used, state the character of same and depth placed, from 3875 feet to 0 feet for each plug set.

Hole filled from 3875 feet to 0 with 13# mud. Wooden plug pushed down with Drill pipe to 400 feet - $\frac{1}{2}$ yard of crushed rock placed on top of wooden plug (Plug 3 feet long). Burlap and Halliburton plug pushed down with drill pipe on top of Rock. Used 20 sac Atlas cement pumped through drill pipe. (Permanent plug 400 feet)

Hole filled from top of cement plug to 35 feet with (13# mud) Permanent plug placed at 35 feet. Cemented with 9 sac Atlas cement from 35 feet to 8 feet.

Hole filled with mud from 8 feet to top (0) using Halliburton cement outfit.

(If additional description is necessary, use BACK of this sheet)

Correspondence regarding this well should be addressed to Clay Brothers Drilling Co., Inc.

Address.....522 Union National Bank Bldg.,.....Wichita, Kansas.....

STATE OF Kansas, COUNTY OF Barton, ss.

.....L. J. Upton.....(employee of owner) or (owner or operator) of the above-described well.

being first duly sworn on oath, says: That I have knowledge of the facts, statements, and matters herein contained and the log of the above-described well as filed and that the same are true and correct. So help me God. *[Signature]*

(Signature)

me God. *L. Lipton*
801 Hartford Great Bend Kans
(Address)

SUBSCRIBED AND SWORN to before me this 21st day of July, 1941.

My commission expires.....**July 28, 1943**



7-11-41

DRILLER'S LOG

WILLIAMS NO. 1

Center Of The E₁ of NE₁ of SE₁ Elevation 1924'
of Sec. 11, Twp. 22S, Rge. 14W

<u>Formation</u>	<u>From</u>	<u>To</u>	<u>Thickness</u>
Caliche	0	50	50
Sand	30	90	60
Sand & Gravel	90	199	109
Clay	199	205	6
Sand & Gravel	205	330	125
Red Bed & Red Rock	330	390	60
Red Bed, Sand & Red Rock	390	540	150
Red Bed & Shells	540	796	256
Anhydrite	796	827	31
Red Bed & Streaks Anhyd.	827	889	62
Red Bed & Shells	889	960	71
Shells & Streaks Gyp	960	1078	118
Red Bed & Shells	1078	1162	84
Blue Shale, Streaks Salt & Shells	1162	1429	267
Shale & Shells	1429	1620	191
Anhydrite & Shale	1620	1673	53
Lime & Anhydrite	1673	1709	36
Shale & Shells	1709	1768	59
Shale, Anhyd., Gyp & Lime Streaks	1768	1887	119
Lime & Shale	1887	2079	192
Lime, Anhyd., Gyp & Streaks Shale	2079	2130	51
Lime & Anhydrite	2130	2173	43
Shale; Lime & Red Rock	2173	2257	84
Shale, Anhyd. & Gyp	2257	2340	83
Lime & Anhyd.	2340	2385	45
Lime & Shale	2385	2466	81
Shale, Red Rock & Lime Shells	2466	2520	54
Shale & Shells	2520	2629	109
Shale, Red Rock & Shells	2629	2768	139
Shale & Shells	2768	2790	22
Hard Lime & Streaks Shale	2790	2810	20
Shale, Red Rock & Shells	2810	2838	28
Shale & Lime	2838	3025	187
Cherty Lime	3025	3074	49
Lime & Shale	3074	3196	122
Shale & Lime Shells	3196	3300	104
Lime & Shale	3300	3369	69
Chert Shale & Lime	3369	3430	61
Broken Lime	3430	3505	75
Shale & Lime	3505	3525	20
Soft Lime	3525	3535	10
Shale & Lime	3535	3602	67
Broken Lime & Shale	3602	3710	108
Lime & Shale	3710	3757	47
Chert Lime & Shale	3757	3788	31
Chert & Lime	3788	3818	30
Lime & Shale	3818	3861	43
Chert & Lime	3861	3875	14
			Total Depth

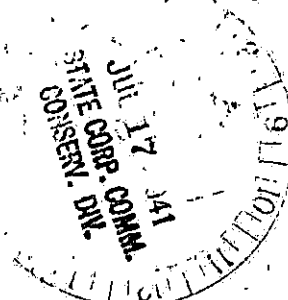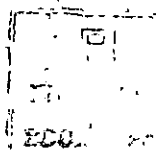

1861
1924
3937