


STATE OF KANSAS
STATE CORPORATION COMMISSION

WELL PLUGGING RECORD

Give All Information Completely
Make Required Affidavit
Mail or Deliver Report to:
Conservation Division
State Corporation Commission
211 No. Broadway
Wichita, Kansas

Stafford County. Sec. 12 Twp. 22S Rge. (E) 13 (W)
Location as "NE/CNW/SE/SW" or footage from lines NW NE SW
Lease Owner Leben Drilling, Inc.
Lease Name Lena Drach Well No. 1
Office Address 905 Central Building, Wichita, Kansas
Character of Well (completed as Oil, Gas or Dry Hole) Dry Hole
Date well completed September 19 19 56
Application for plugging filed September 19 19 56
Application for plugging approved September 19 19 56
Plugging commenced September 19 19 56
Plugging completed September 19 19 56
Reason for abandonment of well or producing formation Dry Hole

NORTH

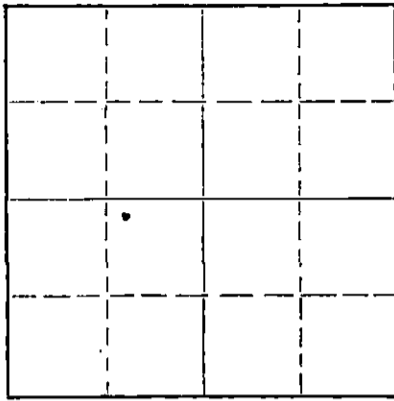

Locate well correctly on above
Section Plat

If a producing well is abandoned, date of last production _____ 19____
Was permission obtained from the Conservation Division or its agents before plugging was commenced? Yes

Name of Conservation Agent who supervised plugging of this well R. M. Brundage
Producing formation _____ Depth to top _____ Bottom _____ Total Depth of Well 3732 Feet
Show depth and thickness of all water, oil and gas formations.

OIL, GAS OR WATER RECORDS

CASING RECORD

FORMATION	CONTENT	FROM	TO	SIZE	PUT IN	PULLED OUT
				8 5/8	272'	

Describe in detail the manner in which the well was plugged, indicating where the mud fluid was placed and the method or methods used in introducing it into the hole. If cement or other plugs were used, state the character of same and depth placed, from _____ feet to _____ feet for each plug set.

Plugged back with crushed rock to 3695'; dumped 5 sacks of cement at 3695' with dump bailer, cement filled up to 3660'; filled hole with mud to 240'; set rock bridge and dumped 20 sacks cement, cement filled up 50 180'; filled hole with mud to 35'; set rock bridge and dumped 10 sacks of cement for cap.

(If additional description is necessary, use BACK of this sheet)

Name of Plugging Contractor Miller Casing Pulling Co.
Address Great Bend, Kansas

STATE OF Kansas, COUNTY OF Sedgwick, ss.
James M. Battin (employee of owner) or owner or operator of the above-described well, being first duly sworn on oath, says: That I have knowledge of the facts, statements, and matters herein contained and the log of the above-described well as filed and that the same are true and correct. So help me God.

(Signature) James M. Battin
905 Central Building, Wichita, Ks.
(Address)

SUBSCRIBED AND SWORN TO before me this 25th day of September, 19 56

My commission expires July 10, 1957

Paul Thomas Notary Public.

RECEIVED
STATE CORPORATION COMMISSION

SEP 26 1956 9-26-56

CONSERVATION DIVISION
Wichita, Kansas

PLUGGING
FILE SEC. 12 T. 22 R. 13w
BOOK PAGE 101 LINE 20

CONTRACTOR'S WELL LOG

Leben Drilling, Inc.
 Lena Drach #1
 NW NE SW of Sec. 12-22S-13W
 Stafford County, Kansas

0	170	Surface Sand	
170	225	Shale and Sand	COMMENCED: August 9, 1956
225	272	Shale and Shells	
272	595	Shale and Red Bed	
595	725	Red Bed and Sand	
725	755	Anhydrite	
755	1512	Shale and Shells	
1512	1671	Lime and Shale	
1671	1987	Shale and Lime	SURFACE CASING:
1987	2203	Lime and Shale	Set 8 5/8" at 272' w/225
2203	3254	Shale and Lime	sks. reg. cement and 4 sks.
3254	3383	Lime and Shale	Ca. Cl.
3383	3599	Lime	
3599	3646	Lime and Chert	
3646	3650	Cherty Lime	
3650	3732	Lime	Set 5 1/2" at 3731' w/75 sks
	3732	<u>Rotary Total Depth</u>	cement.

State of Kansas)
 County of Sedgwick) ss:

I, James M. Battin, do hereby certify that the above and foregoing is a true and correct copy of the log of the Lena Drach #1, NW NE SW of Section 12-22S-13W; Stafford County, Kansas, as reflected by the files of Leben Drilling, Inc..

James M. Battin

Subscribed and Sworn to before me, a Notary Public, in and for Sedgwick County, Kansas, this 31st day of August, 1956.

Jim Thomas

 (Notary Public)

My commission expires July 10, 1957.

PLUGGING
 FILE SEC. 12 T. 22 R. 13W
 BOOK PAGE 101 LINE 20

RECEIVED
 DIVISION
 Staffed, Kansas