


STATE OF KANSAS
STATE CORPORATION COMMISSION
Give All Information Completely
Make Required Affidavit
Mail or Deliver Report to:
Conservation Division
State Corporation Commission
800 Biting Building
Wichita, Kansas

WELL PLUGGING RECORD

Stafford County, Sec. 12 Twp. 22 Rge. (E) 13(W)

Location as "NE/CNW/SW" or footage from lines SW SW SW
Lease Owner Robt K. Lindsley, et al
Lease Name Drach "B" Well No. 1
Office Address 1012 Union Nat'l Bk Bldg, Wichita 2, Kansas
Character of Well (completed as Oil, Gas or Dry Hole) Dry Hole
Date well completed December 30, 1953
Application for plugging filed December 30, 1953
Application for plugging approved December 30, 1953
Plugging commenced December 30, 1953
Plugging completed December 30, 1953
Reason for abandonment of well or producing formation _____

NORTH

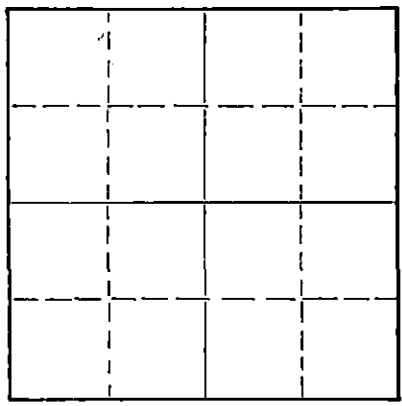

Locate well correctly on above Section Plat

If a producing well is abandoned, date of last production _____ 19____
Was permission obtained from the Conservation Division or its agents before plugging was commenced? Yes

Name of Conservation Agent who supervised plugging of this well M. A. Rives
Producing formation _____ Depth to top _____ Bottom _____ Total Depth of Well 3810 Feet
Show depth and thickness of all water, oil and gas formations.

OIL, GAS OR WATER RECORDS

CASING RECORD

FORMATION	CONTENT	FROM	TO	SIZE	PUT IN	PULLED OUT
				8 5/8"	256.41	None

Describe in detail the manner in which the well was plugged, indicating where the mud fluid was placed and the method or methods used in introducing it into the hole. If cement or other plugs were used, state the character of same and depth placed, from _____ feet to _____ feet for each plug set.

Filled hole to 200' w/drlg mud thru drill pipe. Set bottom plug @ 240' w/20 sax cement, top plug @ 40' w/10 sax cement thru drill pipe.

1-18-54

RECEIVED
STATE CORPORATION COMMISSION
JAN 19 1954
CONSERVATION DIVISION
Wichita, Kansas

(If additional description is necessary, use BACK of this sheet)

Name of Plugging Contractor Lindsley Drilling Company
Address 1012 UNB Bldg, Wichita 2, Kansas

STATE OF Kansas, COUNTY OF Sedgwick, ss.
G. S. Valentine (employee of owner) or owner of the above-described well, being first duly sworn on oath, says: That I have knowledge of the facts, statements, and matters herein contained and the log of the above-described well as filed and that the same are true and correct. So help me God.

(Signature) G. S. Valentine
1012 UNB Bldg, Wichita 2, Kansas
(Address)

SUBSCRIBED AND SWORN to before me this 14th day of January, 19 54
Richard W. Werth
Notary Public.

My commission expires June 5, 1957

PLUGGING
FILE SEC 12 T 22 R 13W
BUCK PAGE 4 LINE 31

DRILLER'S LOG

NO. 1 DRACH "B" - SW SW SW, 12-22-13W, Stafford County, Kansas

Operator & Contractor: Lindsley Drilling Company, Wichita, Kans.

Commenced: December 17, 1953

Completed: December 30, 1953

<u>FORMATION</u>	<u>DEPTH</u>	<u>REMARKS</u>
Sand, Shale, Shells	0 - 235	
Shale	235 - 265	Set 256.41' (5 Jts) 8 5/8" 24#, J-55, Smls Csg w/250 sax cement, 300# CC - circulated.
Redbed, Shells	265 - 740	DS @ 500' - 1°
Anhydrite	740 - 765	
Shale, Shells	765 - 1230	DS @ 1000' - OK
Salt	1230 - 1300	
Salt, Shale	1300 - 1395	
Shale, Shells	1395 - 1610	
Lime, Shale	1610 - 2390	DS @ 1500' - OK DS @ 2000' - OK DS @ 2500' - OK
Shale, Shells	2390 - 22795	Lost circ @ 2750'
Lime, Shale	2795 - 3245	
Shale, Lime Strks	3245 - 3350	
Lime	3350 - 3674	Lost mud @ 3555'
Shale, Lime	3674 - 3717	
Lime, Chert	3717 - 3757	
Simpson	3757 - 3793	
Shale, Chert, Lime	3793 - 3810	T. D. DST @ 3793-3810', Open 1 hr, weak blow for 18 min. Closed 20 min, BHP 12#. Rec 15' drlg mud. Plugged.

I certify that to the best of my knowledge and belief the above is a complete and accurate copy of the drillers' log covering the rotary drilling of the No. 1 Drach "B" as set out above.

G. S. Valentine
G. S. Valentine
Lindsley Drilling Company

TOPS @ Rotary Bushing - Elevation 1899'

Heebber	3243'	(-1344)
Brown Lime	3377'	(1478)
Lansing	3394'	(-1495)
Cherty Conglomerate	3638'	(-1739)
Viola Chert	3698'	(-1799)
Simpson	3756'	(-1857)
Arbuckle	3791'	(-1892)
Total Depth	3810'	(-1911)

RECEIVED
STAFFORD COUNTY, KANSAS
COMMISSION

PLUGGING
FILE REC. 12-22-13W
BOOK PAGE 4 LINE 31