


WELL PLUGGING RECORD

Give All Information Completely
Required Affidavit
Mail or Deliver Report to:
Conservation Division
State Corporation Commission
800 Blitting Building
Wichita, Kansas

NORTH

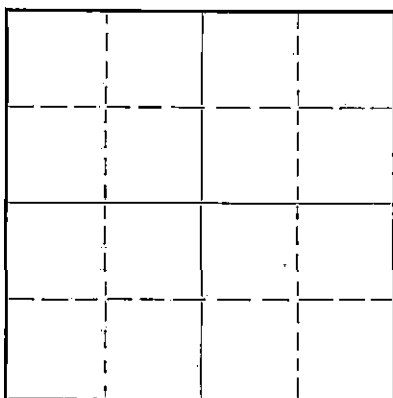

Locate well correctly on above
Section Plat

Stafford County. Sec. 27 Twp. 23 Rge. (E) 12 (W)
Location as "NE/CNW $\frac{1}{4}$ SW $\frac{1}{4}$ " or footage from lines SE SE NW
Lease Owner Herman Kaiser - Veeder Sup. & Devl. Co.
Lease Name Meyer Well No. 2
Office Address Palace Building, Tulsa, Oklahoma
Character of Well (completed as Oil, Gas or Dry Hole) Dry Hole
Date well completed 10-11-50 19
Application for plugging filed 10-11-50 19
Application for plugging approved 10-11-50 19
Plugging commenced 10-11-50 19
Plugging completed 10-11-50 19
Reason for abandonment of well or producing formation

If a producing well is abandoned, date of last production 19
Was permission obtained from the Conservation Division or its agents before plugging was commenced? Yes

Name of Conservation Agent who supervised plugging of this well C.D. Stough Great Bend, Kansas
Producing formation Depth to top Bottom Total Depth of Well 3910 Feet
Show depth and thickness of all water, oil and gas formations.

OIL, GAS OR WATER RECORDS

CASING RECORD

Formation	Content	From	To	Size	Put In	Pulled Out
				8-5/8"	666'	Cemented

Describe in detail the manner in which the well was plugged, indicating where the mud fluid was placed and the method or methods used in introducing it into the hole. If cement or other plugs were used, state the character of same and depth placed, from feet to feet for each plug set.

Set plug at 250' and put 15 sacks of cement on plug. Filled mud to 35'
Set plug at 35' and 10 sacks of cement to 2' under surface of ground.

10-19-50

RECEIVED
STATE CORPORATION COMMISSION
OCT 19 1950
CONSERVATION DIVISION
WICHITA, KANSAS

(If additional description is necessary, use BACK of this sheet)

Correspondence regarding this well should be addressed to Herman Kaiser
Address Palace Building, Tulsa, Oklahoma.

STATE OF KANSAS, COUNTY OF MONTGOMERY, ss.
FLOYD W. HILD (employee of owner) or (owner or operator) of the above-described well,
being first duly sworn on oath, says: That I have knowledge of the facts, statements, and matters herein contained and the log of the above-described well as filed and that the same are true and correct. So help me God.

THE VEEDER SUPPLY & DEVELOPMENT COMPANY
(Signature) Floyd W. Hild

P. O. Box 201, Cherryvale, Kansas
(Address)

SUBSCRIBED AND SWORN to before me this 18th day of October 1950

Loles Lawson
Notary Public.

My commission expires July 11, 1952

PLUGGING
FILE SEC 27 T 23 R 12
BOOK PAGE 35 LINE 37

15-185-12332-0000

Company Herman Geo. Kaiser-Weeder Sup. & Dev'l. Co.

Sec. 27 T. 23 R. 12W

Loc. SE SE NW

County Stafford County, Kansas

Farm Meyer

No. 2

Total Depth 3910'

Comm. 9-29-50

Comp. 10-13-50

Shot or Treated


Contractor Veeder Supply Company

Drilled with Rig - A

Issued

No. of Days - 15

No. of Bits -

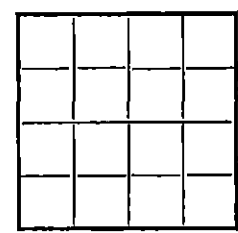

20 in.

10 in.

15 1/2

8 1/4

12 1/2

6 5/8 Set 666' of 8-5/8" Casing Cemented with 385 sax.

13 3/8

5 3/16

Elevation

Production

Figures Indicate Bottom of Formation

Soil Clay Sand	0	150	150
Gray Shale	150	300	150
Red Bed	300	575	275
Shale	575	660	85
Anhydrite	660	690	30
Shale Shells	690	1220	530
Shale Shells Salt	1220	1440	220
Shale Shells	1440	1635	195
Lime Shale	1635	2225	590
Shale Shells	2225	2660	435
Lime Shale	2660	2995	335
Lime	2995	3035	40
Lime Shale	3035	3295	260
Shale	3295	3405	110
Lime	3405	3745	340
Lime Cherty	3745	3795	50
Lime	3795	3815	20
Sandy Lime Shale	3815	3855	40
Shale	3855	3875	20
Arbuckle Lime	3875	3910	35
Total Depth	3910'		

Top Lansing - 3407
 " Conglomerate - 3699
 " Viola - 3734
 " Simpson - 3811
 " Arbuckle - 3879

PLUGGING
 FILE SEC 27 T 23 R 12W
 BOOK PAGE 35 LINE 87

RECEIVED
 STATE CORPORATION COMMISSION
 OCT 19 1950
 CONSERVATION DIVISION
 Wichita, Kansas