

STATE OF KANSAS
STATE CORPORATION COMMISSION

WELL PLUGGING RECORD


Give All Information Completely
Make Request for Permit
Mail or Deliver to:
Conservation Division
State Corporation Commission
800 Bittling Building
Wichita, Kansas

OR

FORMATION PLUGGING RECORD

Strike out upper line
when reporting plugging
of formations.

NORTH

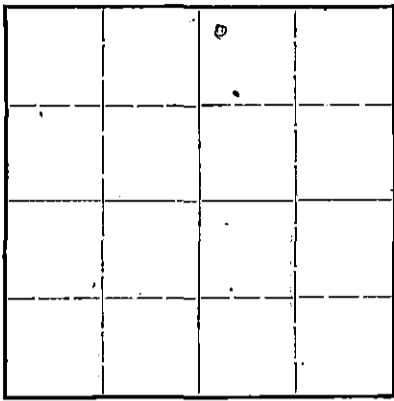

Locate well correctly on above
Section Flat

Stafford County. Sec. 27 Twp. 23 Rge. 12 W (E) (W)
Location as "NE 1/4 NW 1/4 SW 1/4" or footage from lines. NW NW NE
Lease Owner Black-Marshall Oil Co
Lease Name Thole Well No. 1
Office Address Great Bend, Kansas
Character of Well (completed as Oil, Gas or Dry Hole) dry-hole
Date well completed May 31, 1947 19
Application for plugging filed May 31, 1947 19
Application for plugging approved June 3, 1947 19
Plugging commenced 19
Plugging completed May 31, 1947 19
Reason for abandonment of well or producing formation dry-hole

If a producing well is abandoned, date of last production 19
Was permission obtained from the Conservation Division or its agents before plugging was commenced? yes

Name of Conservation Agent who supervised plugging of this well L.C. Pryor
Producing formation Depth to top Bottom Total Depth of Well 3875' Feet
Show depth and thickness of all water, oil and gas formations.

OIL, GAS OR WATER RECORDS

CASING RECORD

Formation	Content	From	To	Size	Put In	Pulled Out
Rotary hole				8 5/8"	280'	none
						cemented with 150 sks
						cement-cement returned

Describe in detail the manner in which the well was plugged, indicating where the mud fluid was placed and the method or methods used in introducing it into the hold. If cement or other plugs were used, state the character of same and depth placed, from...feet to...feet for each plug set.

Gun pits-filled hole with heavy mud pulled drill pipe out to 1937'-
gun pits circulated with heavy mud to 280'-set wood plug @ 280'-run 15
sks cement-filled hole with heavy mud to 10'-set wood plug @ 10'- run 10
sks cement to top of surface.

(If additional description is necessary, use BACK of this sheet)

Correspondence regarding this well should be addressed to Black-Marshall Oil Co
Address Great Bend, Kansas.

STATE OF Kansas, COUNTY OF Stafford, ss.
Walter C. Roberts (employee of owner) or (owner or operator) of the above-described well,
being first duly sworn on oath, says: That I have knowledge of the facts, statements, and matters herein contained and the log of the above-described well as filed and that the same are true and correct. So help me God.

(Signature) Walter C Roberts
Cleflin, Kansas.
(Address)

SUBSCRIBED AND SWORN to before me this 2 day of June 1947

My commission expires Feb. 5, 1951

Edwin Wapjiah
Notary Public.

PLUGGING
FILE SEC 27 T 23 R 12 W
BOOK PAGE 112 LINE 4

6-14-47

15-185-1231-0000

COMPANY: Black-Marshall Oil Company
CONTRACTOR: Black-Marshall Oil Company

FARM: Thole #1
LOCATION: NW NW NE 27-23-12W
Stafford County, Kansas

COMMENCED: 5-18-47
COMPLETED: 5-31-47

CASING RECORD:
8 5/8 @ 280' - 150 sacks

ELEVATION: 1856
PRODUCTION: D&A

Formation	Depth
Sand and Shale	280
Redbed and Shale	480
Redbed and Sand	675
Gyp, redbed and Shale	835
Shale and Redbed	1060
Shale, Shells and Salt	1500
Shells and Sand	1630
Shale and Lime	1755
Lime-	1845
Lime, Shale and Sand	1935
Lime	2095
Shale and Lime	2890
Lime	2925
Shale and Lime	3025
Sandy Lime and Shale	3135
Shale and Lime	3190
Lime	3250
Shale and Broken Lime	3335
Shale and Lime	3493
Lime	3521
Shale and Lime	3593
Lime	3655
Chert, Lime and Shale	3705
Chert and Lime	3749
Chert	3778
Shale	3789
Chert, Sand and Lime	3822
Shale and Lime	3868
Lime	3875
TOTAL DEPTH	3875

TOPS

Lansing	3402
Base K.C.	3694
Viola	3717
Simpson	3790
Arbuckle	3863

STATE OF KANSAS)
) SS
COUNTY OF BARTON)

We heroby certify this to be a correct and accurate log of the above described well as shown by the daily drilling reports.

BLACK-MARSHALL OIL COMPANY

Leon F. Huff

Leon F. Huff, Vice President

Subscribed and sworn to before me this 5th day of June, 1947

Carroll Reinhardt

Notary Public

My commission expires February 19, 1949.

STAMP
JUN 14 1947

PLUGGING
FILE SEC 27 T 23 R 12W
BOOK PAGE 112 LINE 4