

15-185-21810-0000

STATE OF KANSAS
STATE CORPORATION COMMISSION

Form CP-4

Give All Information Completely
Make Required Affidavit
Mail or Deliver Report to:
Conservation Division
State Corporation Commission
212 No. Market
Wichita, Kansas 67202

WELL PLUGGING RECORD

Stafford County, Sec. 28 Twp. 23S Rge. 12W (E) (W)

Location as "NE/CNW/SW" or footage from lines NW 1/4

Lease Owner Gas Marketing Inc.

Lease Name Heyen Well No. 2

Office Address Box 159, Stafford, Kansas 67578

Character of Well (completed as Oil, Gas or Dry Hole) Dry Hole

Date well completed Sept. 10, 19 83

Application for plugging filed yes - telephone 19

Application for plugging approved yes 19


Plugging commenced Oct. 13, 19 83

Plugging completed Oct. 20, 19 83

Reason for abandonment of well or producing formation Lost Hole

If a producing well is abandoned, date of last production 19

Was permission obtained from the Conservation Division or its agents before plugging was commenced? yes

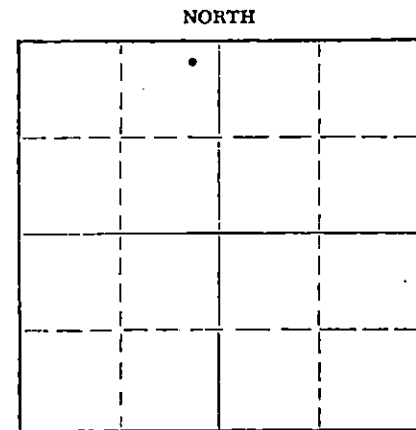

Locate well correctly on above Section Plat

Name of Conservation Agent who supervised plugging of this well J. H. Metz

Producing formation Depth to top Bottom Total Depth of Well 1465 Feet

Show depth and thickness of all water, oil and gas formations.

OIL, GAS OR WATER RECORDS

CASING RECORD

FORMATION	CONTENT	FROM	TO	SIZE	PUT IN	PULLED OUT

Describe in detail the manner in which the well was plugged, indicating where the mud fluid was placed and the method or methods used in introducing it into the hole. If cement or other plugs were used, state the character of same and depth placed, from feet to feet for each plug set.

Hole lost at 1465 ft. due to lost circulation zone at 1120 ft.

2 7/8 tubing was run to 500 ft. and 40 sacks cement with 3% calcium Chloride was pumped out. Tubing was pulled; after two hours ran a wire line and tagged top cement at 730 ft. Ran tubing back to 320 ft., pumped out 35 sacks. Hole appeared to be taking fluid. Pulled tubing, installed 8 5/8 swedge, pumped 25 sacks cement, shut well in.

Next day ran Halliburton wire line. Cement 171 ft. down, put 2 1/4 yards redimix cement in 8 5/8, filled 8 5/8, put 6 inches in bottom of cellar.

RECEIVED
STATE CORPORATION COMMISSION

NOV 9 1983

(If additional description is necessary, use BACK of this sheet)

Name of Plugging Contractor

Address

CONSERVATION DIVISION
Wichita, Kansas

STATE OF Kansas, COUNTY OF Stafford, ss.

Robert L. Austin (employee of owner) or (owner or operator) of the above-described

well, being first duly sworn on oath, says: That I have knowledge of the facts, statements, and matters herein contained and the log of the above-described well as filed and that the same are true and correct. So help me God.

(Signature)

Box 159, Stafford, Kansas 67578

(Address)

Subscribed and Sworn to before me this 8th day of November, 1983

NOTARY PUBLIC

Stafford County, Kansas

Billie Postier
Notary Public.

My commission expires

February 21, 1984