


Give All Information Completely
Make Required Affidavit
Mail or Deliver Report to:
Conservation Division
State Corporation Commission
800 Bittling Building
Wichita, Kansas

12-16-50 WELL PLUGGING RECORD

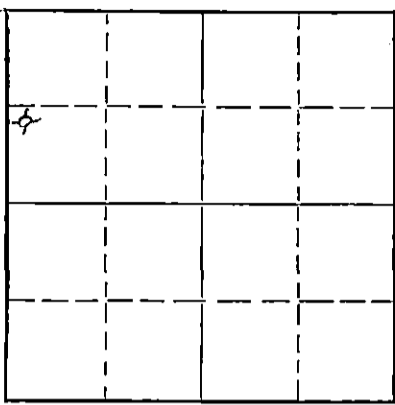

Locate well correctly on above Section Flat

Stafford ^{1101M} County. Sec. 28 Twp. 23 Rge. 12 (E) (W)
Location as "NE/4NW/4SW/4" or footage from lines NW SW NW 1/2
Lease Owner I 338 Brunson Drilling Company, Inc. et al
Well No. I
Office Address 333 First National Bank Bldg.; Wichita, Kansas
Character of Well (completed as Oil, Gas or Dry Hole) Dry
Date well completed 12/12 1950
Application for plugging filed 12/12 1950
Application for plugging approved 12/12 1950
Plugging commenced 12/12 1950
Plugging completed 12/12 1950
Reason for abandonment of well or producing formation Dry
If a producing well is abandoned, date of last production 19
Was permission obtained from the Conservation Division or its agents before plugging was commenced? Yes

Name of Conservation Agent who supervised plugging of this well C. D. Stough; Great Bend, Kansas
Producing formation Depth to top Bottom Total Depth of Well Feet
Show depth and thickness of all water, oil and gas formations.

OIL, GAS OR WATER RECORDS

CASING RECORD

Formation	Content	From	To	Size	Put In	Pulled Out
				8 5/8	158 ft.	
				5 1/2	3826 ft.	2130 ft.

Describe in detail the manner in which the well was plugged, indicating where the mud fluid was placed and the method or methods used in introducing it into the hole. If cement or other plugs were used, state the character of same and depth placed, from feet to feet for each plug set.

Plugged back with crushed rock from 3858' to 3840'. Dumped 5 sac cement at 3840' with dump bailer, top of cement 3805'. Filled hole with mud to 158', set rock bridge, dumped 15 sac cement, top of cement 115'. Filled with mud to 40', set rock bridge, dumped 10 sac cement for cap.

(If additional description is necessary, use BACK of this sheet)

Correspondence regarding this well should be addressed to Brunson Drilling Company, Inc.
Address 333 First National Bank Bldg.; Wichita, Kansas


STATE OF Kansas, COUNTY OF Sedgwick, ss.
Ralph B. McLaughlin (employee of owner) or (owner or operator) of the above-described well, being first duly sworn on oath, says: That I have knowledge of the facts, statements, and matters herein contained and the log of the above-described well as filed and that the same are true and correct. So help me God.

(Signature) *Ralph B. McLaughlin*
BRUNSON DRILLING COMPANY, INC.
333 1st Nat'l Bank Bldg.; Wichita, Kansas
(Address)

SUBSCRIBED AND SWORN to before me this 15th day of December, 1950

Edwina C. Coombs
Notary Public.

My commission expires September 23, 1953

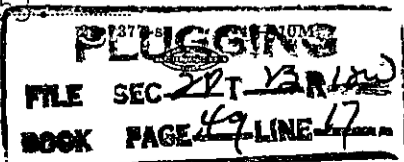

15-185-17333-0000

Brunson Drilling Company, Inc. ET AL

Well: HEYEN #1 NW SW NW/4
 Section 28-23-12
 Stafford County, Kansas
 Commenced RD: 11/12/50
 Completed RD: 11/25/50
 Total Depth: 3849'
 Elevation: 1863 D.F.
 Initial Prod: Dry
 Contractor: Brunson Drilling Co., Inc.
 Casing: 158' 8 5/8" O.D. 8rd thd. 24#
 3826' 5 1/2" O.D. 8rd thd. 14#

STRATA	DEPTH		DEPTH
Surface Soil & Clay	30		
Sand & Gravel	105		
Redbeds	160		
Redbeds & Sand	180		
Redbeds	225		
Sand & redbed	395		
Redbed	655		
Redbeds & Shale	920		
Shale	1150		
Shale & Shells	1215		
Salt	1465	TOPS:	
Shale & Shells	1515		
Shale	1565	Heebner Shale	3235'
Broken Lime	1635	Brown Limestone	3373'
Lime	1930	Lansing- K.C.	3400'
Broken Lime	2110	Conglomerate	3681'
Lime & Shale	2440	Viola Chirt	3717'
Shale & Lime	2825	Simpson	3782'
Shale & Shells	3000	Arbuckle Dolemite	3846'
Lime & Shale	3075		
Shale & Lime	3505		
Lime	3554		
Lime & Shale	3740		
Lime Shale & Chirt	3768		
Chirt & Shale	3785		
Lime Chirt & Shale	3835		
Lime & Shale	3849		
Total Depth	3849		

I hereby certify that the above is a true and correct log of said well as reflected by the daily drilling reports.

BUNSON DRILLING COMPANY, INC.
BY

Ralph B. McLaughlin
Ralph B. McLaughlin, Asst. Sec.

Signed and sworn to in my presence this 7th day of December, 1950, by Ralph B. McLaughlin, Asst. Secretary of the Brunson Drilling Company, Inc., a corporation in the State of Kansas.

Edwina C. Corbin
NOTARY PUBLIC

My commission expires September 23, 1953

RECEIVED
STATE CORPORATION COMMISSION
DEC 16 1950
CONSERVATION DIVISION
Wichita, Kansas

PLUGGING
FILE SEC 28 T 23 R 12W
BOOK PAGE 49 LINE 17