

15-185-112480000

STATE OF KANSAS  
STATE CORPORATION COMMISSION

Form CP-4

Give All Information Completely  
Make Required Affidavit  
Mail or Deliver Report to:  
Conservation Division  
State Corporation Commission  
212 No. Market  
Wichita, Kansas 67202

WELL PLUGGING RECORD

Stafford County. Sec. 28 Twp. 23S Rge. 12W (E)      (W)

Location as "NE/CNW/SW" or footage from lines C NE NE

Lease Owner Gas Marketing Inc.

Lease Name Meyer Well No. 7

Office Address Box 159, Stafford, Kansas 67578

Character of Well (completed as Oil, Gas or Dry Hole) oil

Date well completed \_\_\_\_\_ 19\_\_

Application for plugging filed July 20, 19 77

Application for plugging approved July 22, 19 77


Plugging commenced August 10, 19 77

Plugging completed August 18, 19 77

Reason for abandonment of well or producing formation unknown

If a producing well is abandoned, date of last production unknown 19\_\_

Was permission obtained from the Conservation Division or its agents before plugging was commenced? yes

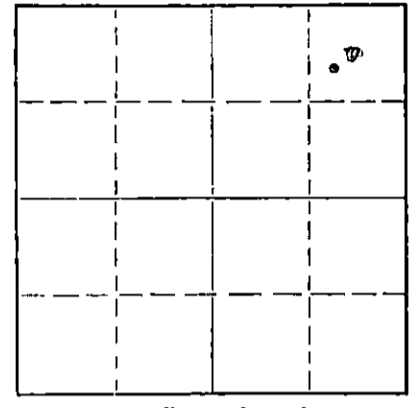

Locate well correctly on above Section Plat

Name of Conservation Agent who supervised plugging of this well Bill Owens

Producing formation Arbuckle Depth to top 3822 Bottom 3837 Total Depth of Well 3837 Feet

Show depth and thickness of all water, oil and gas formations.

OIL, GAS OR WATER RECORDS

CASING RECORD

FORMATION	CONTENT	FROM	TO	SIZE	PUT IN	PULLED OUT

Describe in detail the manner in which the well was plugged, indicating where the mud fluid was placed and the method or methods used in introducing it into the hole. If cement or other plugs were used, state the character of same and depth placed, from \_\_\_\_\_ feet to \_\_\_\_\_ feet for each plug set.

plugged well with 3 sx Halls, 15 sx Gel, 100 sx cement. Gel used was 6%

RECEIVED  
STATE CORPORATION COMMISSION

AUG 22 1977

CONSERVATION DIVISION  
Wichita, Kansas

(If additional description is necessary, use BACK of this sheet)

Name of Plugging Contractor \_\_\_\_\_  
Address \_\_\_\_\_

STATE OF Kansas, COUNTY OF Stafford, ss.

\_\_\_\_\_  
(employee of owner) or (owner or operator) of the above-described well, being first duly sworn on oath, says: That I have knowledge of the facts, statements, and matters herein contained and the log of the above-described well as filed and that the same are true and correct. So help me God.

(Signature) [Handwritten Signature]

Box 159, Stafford, Kansas 67578  
(Address)

BILLIE POSTIER  
Notary Public  
Subscribed and sworn to before me this 19th day of August, 19 77  
Stafford County, Kansas  
MY APPOINTMENT EXPIRES  
February 16, 1980  
My commission expires

Billie Postier  
Notary Public.