


Give All Information Completely
Make Oath and Affidavit
Mud Log Report to:
Conservation Division
State Corporation Commission
800 Bittling Building
Wichita, Kansas

OR

FORMATION PLUGGING RECORD

Strike out upper line
when reporting plug-
ging off formations.

NORTH

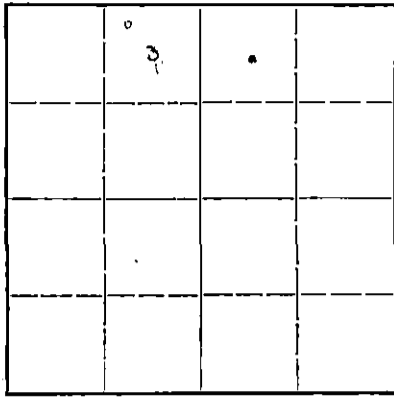

Locate well correctly on above
Section Plat

Stafford County, Sec. 28 Twp. 23 Rge. (E) 12 (W)
Location as "NE $\frac{1}{4}$ NW $\frac{1}{4}$ SW $\frac{1}{4}$ " or footage from lines 330' S. & 990' W. of N/4 Cor.
Lease Owner Cities Service Oil Company
Lease Name Heyen Well No. 1
Office Address Bartlesville, Oklahoma
Character of Well (completed as Oil, Gas or Dry Hole) Oil Well
Date well completed November 6, 1940
Application for plugging filed September 19, 1945
Application for plugging approved September 20, 1945
Plugging commenced September 27, 1945
Plugging completed October 13, 1945
Reason for abandonment of well or producing formation No longer commercially
productive.
If a producing well is abandoned, date of last production September, 1945
Was permission obtained from the Conservation Division or its agents before plugging was com-
menced? Yes

Name of Conservation Agent who supervised plugging of this well H. W. Kerr
Producing formation Arbuckle Depth to top 3841 Bottom 3847 Total Depth of Well 3847 Feet
Show depth and thickness of all water, oil and gas formations.

OIL, GAS OR WATER RECORDS

CASING RECORD

Formation	Content	From	To	Size	Put In	Pulled Out
				8-5/8"	285'	None
				5-1/2"	3839'	2219'

Describe in detail the manner in which the well was plugged, indicating where the mud fluid was placed and the method or methods used in introducing it into the hole. If cement or other plugs were used, state the character of same and depth placed, from _____ feet to _____ feet for each plug set.

5 sacks cement at 3847'
Mud to 250'
Bridge from 250' to 245'
20 sacks cement from 245' to 185'
Mud and soil to 35'
10 sacks cement to base of cellar.

PLUGGING
FILE 28-23-1200
BOOK 26-24

(If additional description is necessary, use BACK of this sheet)


Correspondence regarding this well should be addressed to R. C. Hauber
Address Box 751
Great Bend, Kansas 12-29-45

STATE OF Kansas, COUNTY OF Barton, ss.
V. M. Conover (employee of owner) or (owner or operator) of the above-described well,
being first duly sworn on oath, says: That I have knowledge of the facts, statements, and matters herein contained and the log of the above-
described well as filed and that the same are true and correct. So help me God.

(Signature) *V. M. Conover*
Box 751, Great Bend, Kansas
(Address)

SUBSCRIBED AND SWORN to before me this 28th day of December, 1945

My commission expires March 12, 1947

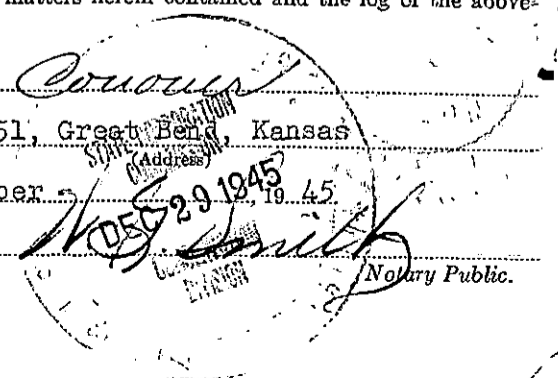

WELL RECORD

15-185-01625-0000

Company Cities Service Oil Co. Well No. 1 Farm Heyen
 Location 330' south & 990' west of N/4 Corner Sec. 28 T. 23 R. 12-W
 Elevation 1858 County Stafford State Kansas
 Drlg. Comm. October 7, 1940 Contractor Hisson Drilling Company
 Drlg. Comp. October 25, 1940 Acid 500 gals. Oct. 29, 1940
 T. D. 3847' Initial Prod. Zoho-Water Potential: 8087 oil, 0 wtr., 24 hrs.

CASING RECORD:

8-5/8" \odot 285' cen. 125 ex Lone Star
 5-1/2" \odot 3839' cen. 75 ex cement

FORMATION RECORD:

surface sand & shale	0-150
water sand hard	160
red bed & shells	285
red bed & shale	670
anhydrite	710
shale & shells	1155
salt, shale & shells	1390
shale & shells	1440
shale & lime	1645
shale	1660
chert & lime	1753
lime	1858
shale & sand	1940
shale	2040
lime	2262
shale	2420
shale & lime	2940
lime	2969
lime & shale	3073
lime	3344
shale & lime	3380
lime	3703
chert	3757
lime	3780
shale & sand	3805
shale	3831
sand (top Arbuckle 3833)	3836
lime	3844-3847 T.D.

3836 rotary T.D. = 3844 S.L.H.

Corr. Top Arbuckle 3841
 Penetration 6'
 Total Depth 3847

Fillup: 750' oil in 1 1/2 hrs.
 3100' oil in 4 hrs.
 3325' oil in 6 hrs.
 3600' oil in 9 hrs.

Syfo: 210' OK
 500' OK
 1040' OK
 1500' OK
 2000' OK
 2500' OK
 3000' OK
 3500' OK

DRILLING
 FILE 28 29 R12W
 BOOK 26 PAGE 24

