


15-185-61624-0000

WELL PLUGGING RECORD

Give All Information Completely
Make Required Affidavit
Mail or Deliver Report to:
Conservation Division
State Corporation Commission
211 No. Broadway
Wichita, Kansas

Stafford County, Sec. 28 Twp. 23S Rge. 12 (E) W (W)
Location as "NE/CNW/SW" or footage from lines. 990' S of N/L & 990' E of W/L
Lease Owner Gas Marketing, Inc.
Lease Name Roy Meyer Well No. 3
Office Address P. O. Box 159, Stafford, Kansas
Character of Well (completed as Oil, Gas or Dry Hole) Oil
Date well completed 3-15-41 19
Application for plugging filed 10-8 1964
Application for plugging approved 19
Plugging commenced 10-22 1964
Plugging completed 10-22 1964
Reason for abandonment of well or producing formation Lost casing at 2680
If a producing well is abandoned, date of last production 1-25 1961
Was permission obtained from the Conservation Division or its agents before plugging was commenced? Yes

NORTH

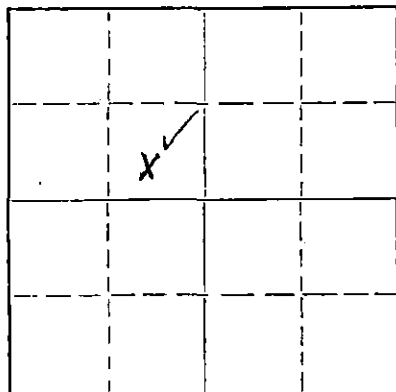

Locate well correctly on above
Section Plat

Name of Conservation Agent who supervised plugging of this well Herman Justus
Producing formation Arbuckle Depth to top 3817 Bottom 3824 Total Depth of Well 3824 Feet
Show depth and thickness of all water, oil and gas formations.

OIL, GAS OR WATER RECORDS

CASING RECORD

FORMATION	CONTENT	FROM	TO	SIZE	PUT IN	PULLED OUT
Arbuckle Lime	Oil & water	3817	3824			
		0	315	9 5/8	315	None
		0	3818	5 1/2		2210

Describe in detail the manner in which the well was plugged, indicating where the mud fluid was placed and the method or methods used in introducing it into the hole. If cement or other plugs were used, state the character of same and depth placed, from _____ feet to _____ feet for each plug set.

Pipe was bridged at 2680 with plug followed with 20 ft. of crushed rock, pipe was shot at 2400 would not pull; shot at 2210 recovered all 2210 ft.: tubing was run to 2000 ft. and 30 sacks cement pumped through tubing; tubing pulled; pushed plug to 180 ft. cement with 30 sack, filled hole with mud to 40 ft. cement with 15 sack.

Sun Cementing doing work

RECEIVED
STATE CORPORATION COMMISSION

RECEIVED
STATE CORPORATION COMMISSION

NOV 2 1964

OCT 27 1964

CONSERVATION DIVISION
Wichita, Kansas

(If additional description is necessary, use BACK of this sheet)

Name of Plugging Contractor Glenn & Smith
Address Ellinwood, Kansas

STATE OF Kansas COUNTY OF Stafford, ss.
Robert A. Austin (employee of owner) or (owner or operator) of the above-described well, being first duly sworn on oath, says: That I have knowledge of the facts, statements, and matters herein contained and the log of the above-described well as filed and that the same are true and correct. So help me God.
(Signature) Robert A. Austin

SUBSCRIBED AND SWORN to before me this 30 day of October, 1964.
My commission expires September 23, 1967
Notary Public.

PLUGGING SUMMARY

15-185-01624-0000

DATE 10-10-64

OWNER Mrs. Marketing Inc.

ADDRESS Box 264 Stafford Kans.

FARM meager

WELL NO. #3

LOCATION S6 - NW - NE - 28 - 238 - 12W.

COUNTY Stafford

TD. 3842

OIL ✓

PLUGGING CONTRACTOR Mrs. Marketing Inc.

NUMBER _____

ADDRESS Stafford Kans.

PUSHER Bob A. Martin

ADDRESS Stafford Kans.

HOW PLUGGED See Mr. Grieder.

I personally checked on this well
There was 2210 ft of 5 1/2" pulled.
But the hole was filled with heavy
Drill mud. Bury Sun Cementing Co.
before pipe was pulled. They
intend to Run 2 1/2" tubing &
squeeze of Bottom of hole
over.

RECEIVED
STATE CORPORATION COMMISSION

OCT 12 1964

CONSERVATION DIVISION
Wichita, Kansas

They will get on it as soon as
as these Regs. are loose.
Herman Justice