

STATE OF KANSAS  
STATE CORPORATION COMMISSION


Give All Information Completely  
Make Required Affidavit  
Mail or Deliver Report to:  
Conservation Division  
State Corporation Commission  
211 No. Broadway  
Wichita, Kansas

WELL PLUGGING RECORD

STAFFORD County, Sec. 29 Twp. 23S Rge. 12W

Location as "NE/CNW/SW" or footage from lines SW NE NE  
Lease Owner REX & MORRIS DRILLING COMPANY, ET AL  
Lease Name RILEY Well No. 1  
Office Address P. O. BOX 334, EL DORADO, KANSAS 67042  
Character of Well (completed as Oil, Gas or Dry Hole) DRY HOLE  
Date well completed 11 DECEMBER 19 65  
Application for plugging filed 11 DECEMBER 19 65  
Application for plugging approved 11 DECEMBER 19 65  
Plugging commenced 11 DECEMBER 19 65  
Plugging completed 11 DECEMBER 19 65  
Reason for abandonment of well or producing formation DRY HOLE

NORTH

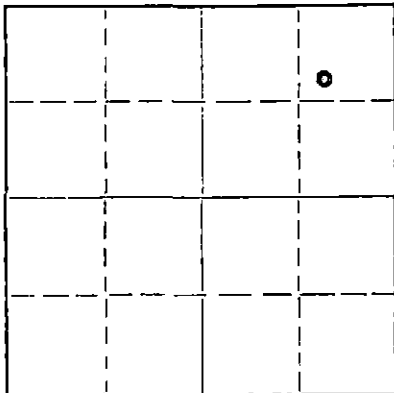

Locate well correctly on above Section Plat

If a producing well is abandoned, date of last production NONE 19  
Was permission obtained from the Conservation Division or its agents before plugging was commenced? YES

Name of Conservation Agent who supervised plugging of this well A. ELVING  
Producing formation NONE Depth to top Bottom Total Depth of Well 3855'RB Feet  
Show depth and thickness of all water, oil and gas formations.

OIL, GAS OR WATER RECORDS

CASING RECORD

FORMATION	CONTENT	FROM	TO	SIZE	PUT IN	PULLED OUT
SURFACE HOLE	WATER	SURFACE	252'RB	8 5/8"OD	247.36'	LEFT IN
(SEE ATTACHED LOG)						

Describe in detail the manner in which the well was plugged, indicating where the mud fluid was placed and the method or methods used in introducing it into the hole. If cement or other plugs were used, state the character of same and depth placed, from feet to feet for each plug set.

FILLED HOLE WITH DRILLING MUD TO 225', SET BRIDGE & HULLS AND CEMENTED WITH 25 SACKS  
CEMENT, FILLED HOLE WITH DRILLING MUD TO 40', SET PLUG & HULLS AND CEMENTED WITH 10 SACKS  
CEMENT. PUT 2 SACKS CEMENT IN RAT HOLE.

RECEIVED  
STATE CORPORATION COMMISSION  
DEC 23 1965  
CONSERVATION DIVISION  
Wichita, Kansas

(If additional description is necessary, use BACK of this sheet)  
Name of Plugging Contractor REX & MORRIS DRILLING COMPANY  
Address P. O. BOX 334, EL DORADO, KANSAS 67042

STATE OF KANSAS COUNTY OF BUTLER, ss.  
A. H. FISHER (employee of owner) or (owner or operator) of the above-described well, being first duly sworn on oath, says: That I have knowledge of the facts, statements, and matters herein contained and the log of the above-described well as filed and that the same are true and correct. So help me God.

(Signature) *A. H. Fisher*  
P. O. BOX 334, EL DORADO, KANSAS 67042 (Address)

SUBSCRIBED AND SWORN TO before me this 21ST day of DECEMBER 19 65  
*Hazel N. Dilts*  
HAZEL N. DILTS Notary Public.

My commission expires 5 MAY 1969

15-185-3022-0000

RILEY # 1

REX & MORRIS, ETAL

Elevation 1869' RB  
1864' GL

Total Depth: 3855' RB  
Contractor: Rex & Morris  
Commenced: 12-3-65  
Completed: 12-11-65  
Initial Prod.: D & A

Location: SW NE NE  
Section 29-23S-12W  
Stafford County, Kansas

Casing Record: 8 5/8" OD  
Set at 242' RB w/250 sacks

FORMATION	DEPTH
Surface Hole	252'
Shale	677'
Anhydrite	700'
Shale	1482'
Lime & Shale	3160'
Lime	3280'
Shale	3376'
Shale & Lime	3400'
Lime - Lansing-KC	3650'
Lime & Shale	3726'
Lime - Viola	3782'
Shale - Simpson	3848'
Lime - Arbuckle - RTD	3855'

RECEIVED  
STATE CONSERVATION COMMISSION  
DEC 23 1965  
CONSERVATION DIVISION  
Wichita, Kansas

I hereby certify the foregoing statements are true and correct to the best of my knowledge and belief.

Rex & Morris Drilling Company

By A. H. Fisher  
A. H. Fisher

STATE OF KANSAS  
COUNTY OF BUTLER, SS.

Subscribed and sworn to before me, a Notary Public, this 21st day of December, 1965.

Hazel N. Dilts  
Hazel N. Dilts, Notary Public

My commission expires: May 5, 1969