


STATE OF KANSAS  
STATE CORPORATION COMMISSION

WELL PLUGGING RECORD

Give All Information Completely  
Make Required Affidavit  
Mail or Report to:  
Conservation Division  
State Corporation Commission  
211 No. Broadway  
Wichita, Kansas

Barton County. Sec. 12 Twp. 16 Rge. 15 (E) W (W)

Location as "NE/CNW/SW" or footage from lines NE SE SW  
Lease Owner Morgenstern & Specter, Inc.  
Lease Name Karst "A" Well No. 1  
Office Address Russell, Kansas  
Character of Well (completed as Oil, Gas or Dry Hole) \_\_\_\_\_  
Date well completed 3-3-59 19\_\_\_\_  
Application for plugging filed November 13, 1961 19\_\_\_\_  
Application for plugging approved November 14, 1961 19\_\_\_\_  
Plugging commenced 11-25-61 19\_\_\_\_  
Plugging completed 11-28-61 19\_\_\_\_  
Reason for abandonment of well or producing formation Depleted.

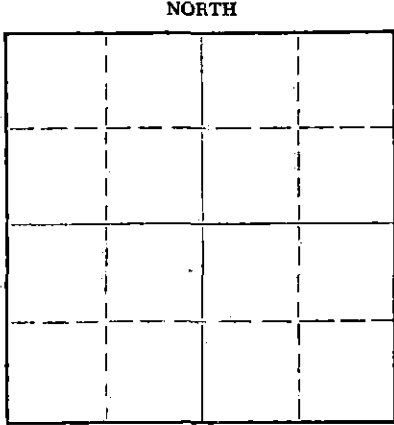

Locate well correctly on above  
Section Plat

If a producing well is abandoned, date of last production \_\_\_\_\_ 19\_\_\_\_  
Was permission obtained from the Conservation Division or its agents before plugging was commenced? yes

Name of Conservation Agent who supervised plugging of this well Don Truan  
Producing formation Kansas City Depth to top 3152 Bottom 3412 Total Depth of Well 3420 Feet  
Show depth and thickness of all water, oil and gas formations.

OIL, GAS OR WATER RECORDS

CASING RECORD

FORMATION	CONTENT	FROM	TO	SIZE	PUT IN	PULLED OUT
				8-5/8"	351'	None
				5-1/2"	3416'	2623'

Describe in detail the manner in which the well was plugged, indicating where the mud fluid was placed and the method or methods used in introducing it into the hole. If cement or other plugs were used, state the character of same and depth placed, from \_\_\_\_\_ feet to \_\_\_\_\_ feet for each plug set.

Checked hole to 3420', ran sand to 3400' and  
dumped 4 sacks of cement @ 3400' with dump  
bailer. Pulled 5 1/2" casing, hooked on to  
surface pipe and pumped in 15 sacks of jell  
mud and 100 sacks of cement.

PLUGGING COMPLETE.

RECEIVED  
STATE CORPORATION COMMISSION  
DEC 15 1961  
CONSERVATION DIVISION  
WICHITA, KANSAS

12-15-61

(If additional description is necessary, use BACK of this sheet)  
Name of Plugging Contractor Knight Casing Pulling Company  
Address Chase, Kansas

STATE OF Kansas, COUNTY OF Rice, ss.  
Noel J. Knight (employee of owner) or (~~owner~~) of the above-described  
well, being first duly sworn on oath, says: That I have knowledge of the facts, statements, and matters herein contained and the log of the  
above-described well as filed and that the same are true and correct. So help me God.

(Signature) Paul J. Knight  
Chase, Kansas  
(Address)

SUBSCRIBED AND SWORN TO before me this 7th day of December, 1961

My commission expires May 20, 1964

Milton J. Volin  
Notary Public.



WELL LOG BUREAU—KANSAS GEOLOGICAL SOCIETY  
508 East Murdock, Wichita, Kansas

RECEIVED  
STATE CORPORATION COMMISSION


NOV 10 1961

Company- WHITE EAGLE OIL CO. AND  
Farm- Karst CENTRAL COMMERCIAL OIL CO.  
No. 1

SEC. 12 CONSERVATION DIVISION  
NE SE SW R 15W  
Wichita, Kansas

Total Depth. 3420'  
Comm. 2-21-59 Comp. 3-3-59  
Shot or Treated.  
Contractor. Peel Brothers, Inc.  
Issued. 9-12-59

County Barton  
KANSAS

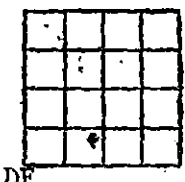

Elevation. 1924' DF

Production. 107 BOPD

Figures indicate Bottom of Formations.

CASING:	
8 5/8"	351' cem.
5 1/2"	3416' cem.
shale & shells	351
shale	425
sand	575
shale red bed	930
Anhydrite	1000
shale & lime	1300
shale & shells	1705
lime	2130
lime & shale	2920
lime	3025
shale & lime	3068
lime	3085
lime & shale	3196
lime	3420
Total Depth	
TOPS: SCOUT	
Heebner	3086
Lansing	3152
Arbuckle	3414