

STATE OF KANSAS
STATE CORPORATION COMMISSION

WELL PLUGGING RECORD


Give All Information Completely
Make Required Affidavit
Mail or Deliver Report to:
Conservation Division
State Corporation Commission
800 Biting Building
Wichita, Kansas

OR

FORMATION PLUGGING RECORD

Strike out upper line
when reporting plugging
of formations.

Stafford County. Sec. 4 Twp 22S Rge 12 (W)
Location as "NE 1/4 NW 1/4 SW 1/4" or footage from lines SE SE SE
Lease Owner Petroleum, Inc.
Lease Name Schrader Well No. 1
Office Address 100 Derby Building, Wichita 2, Kansas
Character of Well (completed as Oil, Gas or Dry Hole) Dry Hole
Date well completed October 21, 1949
Application for plugging filed December 5, 1949
Application for plugging approved 1949
Plugging commenced November 19, 1949
Plugging completed November 26, 1949
Reason for abandonment of well or producing formation

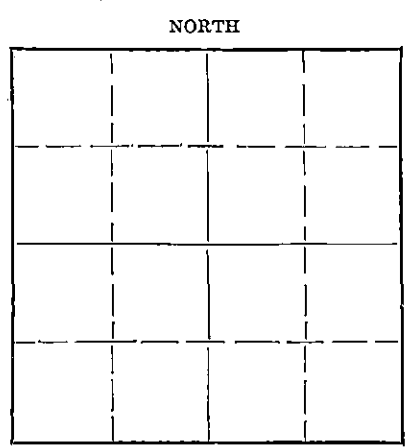

Locate well correctly on above
Section Plat

If a producing well is abandoned, date of last production 19
Was permission obtained from the Conservation Division or its agents before plugging was commenced? Yes
C. D. Stough, Box 207, Great Bend, Ks.

Name of Conservation Agent who supervised plugging of this well
Producing formation Depth to top Bottom Total Depth of Well 3649 Feet
Show depth and thickness of all water, oil and gas formations.

OIL, GAS OR WATER RECORDS

CASING RECORD

Formation	Content	From	To	Size	Put In	Pulled Out
				8 5/8	216.57	
				5 1/2	3654.65	3134'

Describe in detail the manner in which the well was plugged, indicating where the mud fluid was placed and the method or methods used in introducing it into the hole. If cement or other plugs were used, state the character of same and depth placed, from feet to feet for each plug set.

Dumped 6 sacks of cement at bottom of hole.
Shot pipe off at 3100'. Pulled pipe and
mudded hole to 250'. Dumped 15 sacks of
cement at 250'. Finished mudding hole and
dumped 10 sacks of cement at top of surface.

12-9-49
DEC 9 - 1949
ST
KANSAS

(If additional description is necessary, use BACK of this sheet)
Correspondence regarding this well should be addressed to PETROLEUM, INC.
Address 100 Derby Building, Wichita 2, Kansas

STATE OF KANSAS, COUNTY OF SEDGWICK, ss.

(employee of owner) or (owner or operator) of the above-described well,
being first duly sworn on oath, says: That I have knowledge of the facts, statements, and matters herein contained and the log of the above-described well as filed and that the same are true and correct. So help me God.

(Signature) Eric H. Jage
100 Derby Building, Wichita 2, Kansas
(Address)

SUBSCRIBED AND SWORN to before me this 5th day of December 1949.
Marjorie Bradshaw
Notary Public.

My commission expires October 27, 1952

FILE SEC 4 T 22R 12
BOOK PAGE 128 LINE 17

WELL LOG SCHRADER NO. 1

Petroleum, Inc., Lease Owner

Section 4, Twp. 22S, Rge. 12W

Drillers, Inc., Contractor

Location: SE Cor.

Rotary Total Depth: 3649'

County: Stafford, Kansas

Commenced: October 9, 1949

Production:

Completed: October 21, 1949

Elevation: 1861 D.F.

Casing: 216.57' of 8 5/8"
3654.65' of 5 1/2"

Figures below indicate bottom of formation.

	<u>Tons</u>
150 Sand	650 Anhydrite
206 Shale & Shells	3148 Heebner
650 Shale & Red Bed	3167 Toronto
690 Anhydrite	3283 Br. Lime
980 Shale & Red Rock	3303 Lansing
1160 Shale & Shells	3516 B.K.C.
1400 Shale	3545 P.B.C.
1460 Shale & Shells	3548 Viola
2070 Lime	3587 Simpson
3310 Lime & Shale	3644 Arbuckle
3519 Lime	
3546 Shale & Lime	
3574 Viola (Chert)	
3587 Chert	
3644 Shale	
3649 Lime	

3649 Rotary Total Depth

I hereby certify that this is a true and correct log of the above mentioned well.

Petroleum, Inc.

Eric H. Jager
Eric H. Jager

STATE OF KANSAS :
: SS.
SEDGWICK COUNTY :

Subscribed to and sworn to before me, a Notary Public in said County and State this 28th day of October, 1949.

Rosemond Koch
Notary Public

My Commission Expires: June 7, 1952.

PLUGGING
FILE SEC 1-22-172
BOOK PAGE 18 LINE 7