

STATE OF KANSAS
STATE CORPORATION COMMISSION

WELL PLUGGING RECORD

Give All Information Completely
Make Required Affidavit
Mail or Deliver Report to:
Conservation Division
State Corporation Commission
800 Biting Building
Wichita, Kansas


OR

FORMATION PLUGGING RECORD

Strike out upper line
when reporting plugging
of formations.

NE Stafford County. Sec. 4 Twp. 22 Rge. 12 (B) (W)
Location as "NE 1/4 NW 1/4 SW 1/4" or footage from lines. NE SE NE
Lease Owner Morris Garvin and Pickrell Drilling Company, Inc.
Lease Name Bertha Stargel Well No. 1
Office Address 705 4th Nat'l Bank Bldg., Wichita 2, Kansas
Character of Well (completed as Oil, Gas or Dry Hole) Dry Hole
Date well completed 7/11 19 49
Application for plugging filed 7/11 19 49
Application for plugging approved 7/11 19 49
Plugging commenced 7/11 19 49
Plugging completed 7/11 19 49
Reason for abandonment of well or producing formation Dry Hole

NORTH

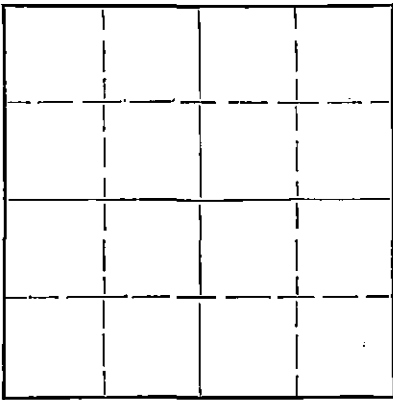

Locate well correctly on above
Section Plat

Name of Conservation Agent who supervised plugging of this well C. D. Stough
Producing formation Aronklo Depth to top 3661 Bottom Total Depth of Well 3682 Feet
Show depth and thickness of all water, oil and gas formations. Derrick Floor Measurements.

OIL, GAS OR WATER RECORDS

CASING RECORD

Formation	Content	From	To	Size	Put In	Pulled Out
Sand, Shale, Red Rock		0	290'	8 5/8"	290'	None
	No Oil String Run.					

Describe in detail the manner in which the well was plugged, indicating where the mud fluid was placed and the method or methods used in introducing it into the hole. If cement or other plugs were used, state the character of same and depth placed, from _____ feet to _____ feet for each plug set.

Hole was filled from total depth to 285' with heavy mud. Hole was bridged at 285' and 15 sacks cement run on top of bridge. Hole then mudded to 30'. Hole was bridged again and filled with 10 sacks cement to top of cellar.

7-21-49

(If additional description is necessary, use BACK of this sheet)

Correspondence regarding this well should be addressed to Pickrell Drilling Company, Inc.
Address 705 Fourth National Bank Building, Wichita 2, Kansas.

STATE OF KANSAS, COUNTY OF SEDGWICK, ss:
C. W. SEBIPS (employee of owner) or (owner or operator) of the above-described well,
being first duly sworn on oath, says: That I have knowledge of the facts, statements, and matters herein contained and the log of the above-described well as filed and that the same are true and correct. So help me God.

(Signature) [Signature]

705 Fourth National Bank Bldg. Wichita, Kansas.
(Address)

SUBSCRIBED AND SWORN to before me this 15th day of July, 1949

[Signature] Notary Public.

My commission expires January 28, 1953.

PLUGGING
FILE SEC 4 T 28 R 12
BOOK PAGE 105 LINE 6

COMPANY: MORRIS GARVIN and PICKRELL DRILLING COMPANY, INC. Rotary Drilling Commenced: 6/30/49
 Rotary Drilling Completed: 7/11/49

LOCATION: NE SE NE Section 4-22-12W Stafford County, Kansas

CONTRACTOR: PICKRELL DRILLING COMPANY, INC. Wichita, Kansas

CASING RECORD: 290' (9jts.) 8 5/8" 2 1/4" casing set at 290' in a 12 1/2" hole, cemented with 175 sacks cement.

Drilled 7 7/8" hole from 290' to 3685 TD.

LOG

(Figures indicate bottom formation - measurements from top rotary bushing.)

Cellar	5	Circulated for samples at 3438'
Sand	130	" " " " 3495'
Shale & Sand Rock	220	" " " " 3617'
Red Rock	545	" " " " 3685'
Lime	570	
Shale	910	
Shale & Shells	1165	
Salt	1250	Slope test at 1000' - 0° off.
Salt & Shale	1445	" " " 1500' - 0° off.
Shale & Lime	1720	" " " 2000' - 0° off.
Lime	1811	" " " 2500' - 0° off.
Lime & Shale	1875	" " " 3175' - 0° off.
Sand	1905	SIM at 3175' OK.
Shale & Lime	2305	SIM at 3450' OK.
Broken Lime & Shale	2435	Slope test at 3685' - 0° off.
Lime & Shale	2820	
Shale	2853	
Lime	2980	
Sandy Lime	3030	
Shale & Sandy Lime	3095	
Lime	3269	
Shale & Lime	3305	
Lime	3570	
Chert	3597	
Viola Chert	3607	
Cherty Lime & Shale	3632	
Lime	3685 Rotary TD	

The undersigned, C. W. Sebitts, Secretary of PICKRELL DRILLING COMPANY, INC., hereby certifies in behalf of said corporation, that the above log is a true and correct log of the formation encountered in drilling the above well as reflected by the Daily Drilling Reports.

PLUGGING
 FILE SEC 4-22-12W
 BOOK PAGE 105 LINE 6

PICKRELL DRILLING COMPANY, INC.

By C. W. Sebitts
 Secretary

STATE OF KANSAS)
 COUNTY OF SMITH) SS

JUL 21 1949

BE IT REMEMBERED that on this 12th day of July, 1949, before me, the undersigned, a Notary Public, duly commissioned, in and for the county and state aforesaid, came C. W. Sebitts, Secretary of Pickrell Drilling Company, Inc., a corporation of the State of Kansas, personally known to me to be such officer, and to be the same person who executed as such officer the foregoing instrument of writing in behalf of said corporation, and he duly acknowledged the execution of the same for himself and for said corporation.

IN WITNESS WHEREOF, I have hereunto set my hand and official seal on the day and year last above written.

Ethel Zimmerman
 Notary Public

My commission expires January 23, 1953.