

STATE OF KANSAS  
STATE CORPORATION COMMISSION

WELL PLUGGING RECORD


OR  
FORMATION PLUGGING RECORD

Strike out upper line when reporting plugging of formations.

Give All Information Completely  
Make Required Affidavit  
Mail or Deliver Report to:  
Conservation Division  
State Corporation Commission  
800 Biting Building  
Wichita, Kansas

Stafford County, Sec. 6 Twp. 23S Rge. (E) 12 (W)

4-228 NORTH 12N

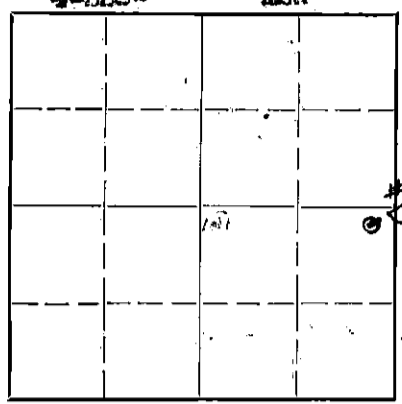

Locate well correctly on above Section Plat

Location as "NE 1/4 NW 1/4 SW 1/4" or footage from lines. NE NE 1/4  
Lease Owner Holmerich & Payne  
Lease Name Schrader Well No. 1  
Office Address 413 Philtower, Tulsa, Oklahoma.  
Character of Well (completed as Oil, Gas or Dry Hole) Dry  
Date well completed 3-30 1944  
Application for plugging filed 3-30 1944  
Application for plugging approved 3-30 1944  
Plugging commenced 3-30 1944  
Plugging completed 3-30 1944  
Reason for abandonment of well or producing formation Dry hole  
If a producing well is abandoned, date of last production Dry 19  
Was permission obtained from the Conservation Division or its agents before plugging was commenced? Yes

Name of Conservation Agent who supervised plugging of this well C. T. Alexander  
Producing formation None Depth to top Bottom Total Depth of Well 3667 Feet  
Show depth and thickness of all water, oil, and gas formations.

OIL, GAS OR WATER RECORDS

CASING RECORD

Formation	Content	From	To	Size	Put In	Pulled Out
				10 3/4" OD	190'	None

Describe in detail the manner in which the well was plugged, indicating where the mud fluid was placed and the method or methods used in introducing it into the hold. If cement or other plugs were used, state the character of same and depth placed, from feet to feet for each plug set.

Hole filled with heavy mud from 3667' to 190'. Ridge set at 190'. 15 sacks cement dumped on top of bridge. Filling to 161'. Heavy mud from 161' to 26'. 10 sacks cement on top of bridge at 26' - filling to bottom of cellar.

PLUGGING  
FILE NO. 4 22-1214  
BOOK PAGE 113 LINE 24

4-5-44

(If additional description is necessary, use BACK of this sheet)  
Correspondence regarding this well should be addressed to Holmerich & Payne, Inc.  
Address 413 Philtower Building, Tulsa 3, Oklahoma;

STATE OF Oklahoma, COUNTY OF Tulsa, ss.  
T. Harry Saye (employee of owner) or (owner or operator) of the above-described well,

being first duly sworn on oath, says: That I have knowledge of the facts, statements, and matters herein contained and the log of the above-described well as filed and that the same are true and correct. So help me God.

(Signature) Harry Saye  
413 Philtower Building (Address)

SUBSCRIBED AND SWORN to before me this 3rd day of April, 1944

My commission expires July 22, 1947

Sue Griffin Notary Public

Schrader No. 1  
NE Corner SE/4 Section 4-22S-12W  
Stafford County, Kansas  
Wanda Oil Corporation


Commenced: March 9, 1944  
 Completed: March 30, 1944

Surface clay	0	35
Sand	35	70
Sand and shells	70	182
Lime	182	305
Red bed and shale	205	390
Red bed and shells	390	775
Shale, shells and red bed	775	1075
Shale and shells	1075	1550
Anhydrite	1550	1582
Lime	1582	1650
Shale	1650	1685
Lime and streaks of shale	1685	1720
Lime	1720	1780
Lime and shale	1780	1900
Lime	1900	2145
Lime and shale	2145	2390
Broken lime	2390	2455
Lime and shale	2455	2935
Topeka lime	2935	2960
Shale and lime	2960	3095
Lime	3095	3145
Lime and shale	3145	3335
Lime	3335	3527
Conglomerate, cherty	3527	3545
Cherty lime	3545	3584
Shale and cherty lime	3584	3592
Shale and lime	3592	3611
Lime and shale	3611	3667
TOTAL DEPTH	3667	

Casing Record:  
 10 3/4" casing set at 190' and cemented with  
 200 sacks cement

STATE OF OKLAHOMA )  
 COUNTY OF TULSA ) ss.

I hereby affirm that the above and foregoing is a true and correct copy of the log of your Schrader Well No. 1, located in the Northeast Corner of the Southeast Quarter of Section 4, Township 22 South, Range 12 West, Stafford County, Kansas.

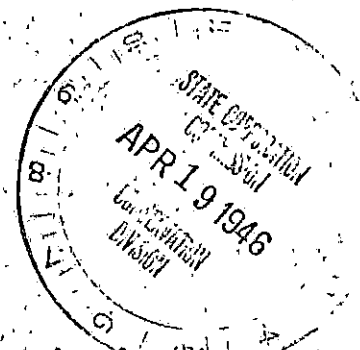

HELM RICH & PAYNE, INC.

4 22 12W  
 113 24

By William B. ...  
 Treasurer

Subscribed and sworn to before me, a Notary Public, this 5th day of April, 1944:

Chas. Griffin  
 Notary Public

My commission expires July 22, 1947.