

STATE OF KANSAS
STATE CORPORATION COMMISSION

WELL PLUGGING RECORD

FORMATION PLUGGING RECORD


Give All Information Completely
Make Required Affidavit
Mail or Deliver Report to:
Conservation Division
State Corporation Commission
800 Bitting Building
Wichita, Kansas

OR

Strike out upper line
when reporting plug-
ging off formations.

Stafford County, Sec. 4 Twp. 22 Rge. (E) 12 (W)

Location as "NE $\frac{1}{4}$ NW $\frac{1}{4}$ SW $\frac{1}{4}$ " or footage from lines SW $\frac{1}{4}$ SW $\frac{1}{4}$ SE $\frac{1}{4}$
Lease Owner Bishop Oil Company et al.
Lease Name Schrader Well No. 1
Office Address Brown Building, Wichita, Kansas.
Character of Well (completed as Oil, Gas or Dry Hole) Dry
Date well completed February 11, 19 49
Application for plugging filed February 17, 19 49
Application for plugging approved 19
Plugging commenced February 17, 19 49
Plugging completed March 2, 19 49
Reason for abandonment of well or producing formation. DRY

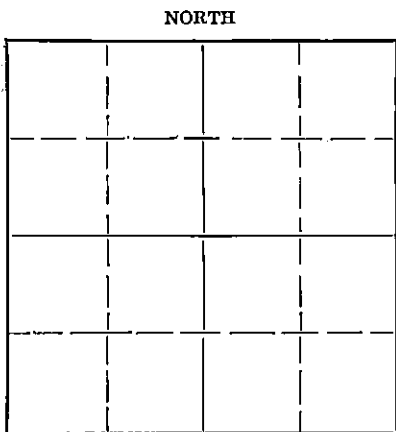

Locate well correctly on above
Section Plat

If a producing well is abandoned, date of last production 19
Was permission obtained from the Conservation Division or its agents before plugging was com-
menced? Yes

Name of Conservation Agent who supervised plugging of this well C. D. Stough
Producing formation Depth to top Bottom Total Depth of Well 3684 Feet
Show depth and thickness of all water, oil and gas formations.

OIL, GAS OR WATER RECORDS

CASING RECORD

Formation	Content	From	To	Size	Put In	Pulled Out
				8-5/8"	298'	None
				5-1/2"	3665 1/2'	2908'

Describe in detail the manner in which the well was plugged, indicating where the mud fluid was placed and the method or methods used in introducing it into the hole. If cement or other plugs were used, state the character of same and depth placed, from feet to feet for each plug set.

Bottom of hole plugged back from 3670' to 3645' and cemented with 5 sax. 5 1/2"
Casing cut off at 2908' and pulled out. Hole filled with mud up to 300', rock
bridge put in at 300' and cemented with 15 sax. Surface pipe bridged at base of
cellar and cemented with 10 sax.

RECEIVED
Conservation Div.
MAR 8 - 1949
STATE CORPORATION
COMMISSION
KANSAS
3-8-49

(If additional description is necessary, use BACK of this sheet)

Correspondence regarding this well should be addressed to Bishop Oil Company
Address Brown Building, Wichita, Kansas.

STATE OF KANSAS, COUNTY OF SEDGWICK, ss.
Lewis Stoy (employee of owner) or (owner or operator) of the above-described well,

being first duly sworn on oath, says: That I have knowledge of the facts, statements, and matters herein contained and the log of the above-described well as filed and that the same are true and correct. So help me God.

(Signature) Lewis Stoy
1923 Monroe St., Gt. Bend, Kansas.
(Address)

SUBSCRIBED AND SWORN to before me this 7th day of March, 19 49

My commission expires July 9, 1952.

Alfred F. Sholsky
Notary Public.

PLUGGING
FILE SEC 4 T 22 R 120
BOOK PAGE 83 LINE 28

SCHRAEDER # 1

Casing Record:	COMPANY:	Bishop Oil Co. and Aylward Drilling Co.	Location:	SW $\frac{1}{4}$ SW $\frac{1}{4}$ SE $\frac{1}{4}$ of Section 4-228-12W, Stafford County, Kansas
8 5/8" - 298'	CONTRACTOR:	Aylward Drilling Co.	COMENCED:	January 20, 1949
5" - 3665'	COMPLETED:	February 11, 1949	ELEVATION:	1866'
			POTENTIAL:	DRY

	<u>From</u>	<u>To</u>
Clay and sand	0	55
Shale	55	80
Sand	80	200
Shale and shells	200	298
Red Bed	298	430
Shale and shells	430	675
Anhydrite	675	700
Shale and shells	700	1457
Shale	1457	1520
Shale and Lime	1520	1853
Lime	1853	1936
Lime, Broken	1936	2200
Lime	2200	2228
Shale and Shells	2228	2260
Shale	2260	2305
Shale and shells	2305	2670
Shale and lime shells	2670	2690
Shale and shells	2690	2740
Shale	2740	2790
Shale and Lime	2790	2900
Lime and shale	2900	3067
Lime, Broken	3067	3100
Lime and shale	3100	3135
Lime	3135	3256
Lime and Shale	3256	3330
Lime	3330	3416
Lime and chert	3416	3447
Lime	3447	3536
Lime (Hard)	3536	3555
Lime	3555	3560
Cherty Lime	3560	3635
Lime and shale	3635	3662
Sand and shale	3662	3665
Arbuckle	3665	3684

Set 8 5/8" Casing at 298'
and Cemented W/ 175 Sax

Set 5 1/2" Casing at 3665'
and Cemented W/ 100 Sax

FORMATION TOPS:

Heebner	3159
Br. Lime	3293
Lansing	3318
Viola	3557
Simpson	3606
Arbuckle	3665

2 bailers of water in 30 minutes @ 3676 to 80.
7 bailers of water in 50 minutes @ 3676 to 84.
Plugged back to 3674'. Perf. 31 shots 3644-66. No show.
Dry and abandoned.

I certify that this is a true and correct copy of the above log, to the best of my knowledge.

[Signature]
A. Skelsky

Subscribed and sworn to before me
this 17th day of February, 1949.

[Signature]
NOTARY PUBLIC

My Commission Expires
July 16, 1952.

RECEIVED
FEB 18 1949
STATE INFORMATION
COMMISSION
KANSAS

PLUGGING
FILE SEC 4-228-12W R 114W
BOOK PAGE 83 LINE 28