


WELL PLUGGING RECORD

Give All Information Completely
Make Required Affidavit
Mail or Deliver Report to:
Conservation Division
State Corporation Commission
800 Biting Building
Wichita, Kansas

Stafford County, Sec. 4 Twp. 22 Rge. (E) 12 (W)
Location as "NE/CNW/SW" or footage from lines SW NW SE
Lease Owner Anschutz Drilling Co.
Lease Name Schrader Well No. 1
Office Address 1019 Central Bldg., Wichita, Kansas
Character of Well (completed as Oil, Gas or Dry Hole) Oil
Date well completed 9-6-19 51
Application for plugging filed 7-20-19 56
Application for plugging approved 7-20-19 56
Plugging commenced 7-31-19 56
Plugging completed 8-3-19 56
Reason for abandonment of well or producing formation Depleted

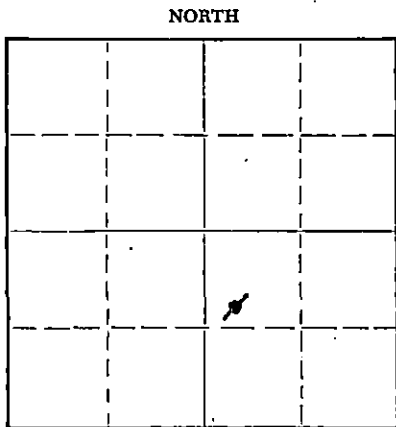

Locate well correctly on above Section Plat

If a producing well is abandoned, date of last production 7-25-1956
Was permission obtained from the Conservation Division or its agents before plugging was commenced? Yes

Name of Conservation Agent who supervised plugging of this well
Producing formation Arbuckle Depth to top 3647 Bottom 3650 Total Depth of Well 3647 P. Feet
Show depth and thickness of all water, oil and gas formations.

OIL, GAS OR WATER RECORDS

CASING RECORD

FORMATION	CONTENT	FROM	TO	SIZE	PUT IN	PULLED OUT
Arbuckle	Oil	3647		8-5/8" OD	275'	None
				5-1/2" OD	3643'	2920

Describe in detail the manner in which the well was plugged, indicating where the mud fluid was placed and the method or methods used in introducing it into the hole. If cement or other plugs were used, state the character of same and depth placed, from _____ feet to _____ feet for each plug set.

3647 - 3640 - sand
3640 - 3615 - 5 sacks cement
3615 - 250 - mud
250 - 240 - rock bridge
240 - 180 - 20 sack cement
180 - 35 - mud
35 - cellar - 10 sacks cement

RECEIVED
STATE CORPORATION COMMISSION
AUG 10 1956
CONSERVATION DIVISION
WICHITA, KANSAS

8-10-56

(If additional description is necessary, use BACK of this sheet)
Name of Plugging Contractor R. & S Pipe Pulling Co.
Address Ellinwood, Kansas

STATE OF KANSAS, COUNTY OF SEDGWICK, ss. Agent
John W. Ritchey (employee of owner) or (owner or operator) of the above-described well, being first duly sworn on oath, says: That I have knowledge of the facts, statements, and matters herein contained and the log of the above-described well as filed and that the same are true and correct. So help me God.

(Signature) *John W. Ritchey*
1019 Central Bldg., Wichita 2, Kansas
(Address)

SUBSCRIBED AND SWORN to before me this 8th day of August, 19 56

My commission expires April 23, 1958

Notary Public.

PLUGGING
FILE SEC. 4 T 22 R 12W
BOOK PAGE 82 LINE 18

ANSCHUTZ DRILLING CO., INC.

#1 Schrader SW NE 4-225-12W
Stafford County, Kansas

0	215	Sand
815	220	Shells
875	274	Shale & shells
874	290	Red shale
890	675	Red bed
678	695	Anhydrite
695	925	Shale & shells
925	1170	Shale, lime & salt
1170	1400	Shale
1400	1570	Shale
1570	1680	Lime
1680	1755	Lime & shale
1755	1935	Lime
1935	2035	Lime & shale
2035	2119	Lime
2119	2235	Lime & shale
2235	2405	Lime & shale
2405	2595	Shale
2595	2955	Shale & lime
2955	3160	Lime
3160	3200	Lime & shale
3200	3514	Lime
3514	3567	Lime, shale & chert
3567	3565	Chert
3565	3638	Lime
3638	3645	Shale & lime
3645	3650	Shale & lime
	3650	Total Depth

COMMENCED: 8/17/51
COMPLETED: 8/31/51

ELEVATIONS:
1867 DF
1870 RB

TOPS:

Freebner 3144 (-1274)
Brown Lime 3278 (-1408)
Lensing 3200 (-1420)
Donal 3550 (-1680)
Simpson 3588 (-1718)
Arbuckle 3647 1/2 (-1777 1/2)

CASING RECORD

Set 8-5/8" surface casing at
275' with 200 sacks cement.
Set 5 1/2" oil string at 3643'
with 100 sacks cement.

STATE OF KANSAS)
COUNTY OF SEDGWICK) SS

I hereby affirm that the above and foregoing is a true and correct copy of the log of the #1 Schrader located SW NE 4-225-12W, Stafford County, Kansas.

ANSCHUTZ DRILLING COMPANY

B: *H. E. Williams*

Subscribed and sworn to before me this 7th day of September, 1951.

Notary Public

My commission expires January 21, 1954.

RECEIVED
STATE CORPORATION COMMISSION

356

CORPORATION DIVISION
TOPEKA, Kansas

PLUGGING
FILE SEC. 4 T. 22 R. 12W
BOOK PAGE 82 LINE 18