


STATE OF KANSAS
STATE CORPORATION COMMISSION

WELL PLUGGING RECORD

Give All Information Completely
Make Required Affidavit
Mail or Deliver Report to
Conservation Division
State Corporation Comm.
245 North Water
Wichita, KS 67202

Stafford County. Sec. 4 Twp. 22S Rge. 12W ~~XXX~~
Location as "NE/CNW $\frac{1}{4}$ SW $\frac{1}{4}$ " or footage from lines _____
C- NE NE NE

Lease Owner Murfin Drilling Company
Lease Name Stargel Well No. 1
Office Address 617 Union Center, Wichita, Ks 67202
Character of Well (Completed as Oil, Gas or Dry Hole) _____
Dry Hole

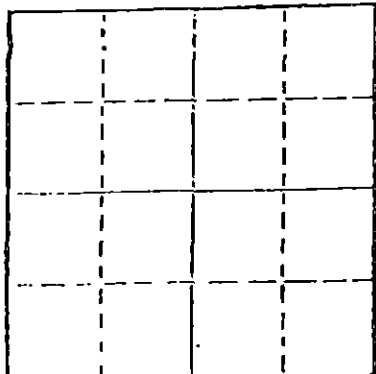

Locate well correctly on above
Section Plat

Date Well completed August 12, 1978
Application for plugging filed Verbal Application 19__
Application for plugging approved Verbal Approval 19__
Plugging commenced August 12, 1978
Plugging completed August 12, 1978
Reason for abandonment of well or producing formation _____

If a producing well is abandoned, date of last production _____ 19__

Was permission obtained from the Conservation Division or its agents before plugging was commenced? Yes

Name of Conservation Agent who supervised plugging of this well Wm. T. Owen
Producing formation _____ Depth to top _____ Bottom _____ Total Depth of Well 3,730'
Show depth and thickness of all water, oil and gas formations.

OIL, GAS OR WATER RECORDS

CASING RECORD

| FORMATION | CONTENT | FROM | TO | SIZE | PUT IN | PULLED OUT |
|-----------|---------|------|----|--------|--------|------------|
| | | | | 8-5/8" | 350' | None |
| | | | | | | |
| | | | | | | |
| | | | | | | |

Describe in detail the manner in which the well was plugged, indicating where the mud fluid was placed and the method or methods used in introducing it into the hold. If cement or other plugs were used, state the character of same and depth placed, from _____ feet to _____ feet for each plug set.

Filled hole with heavy rotary mud from 3,730 ft. (rotary total depth) to 540 ft. Set plug at 540 ft. and cemented with 40 sacks cement. Filled hole with heavy rotary mud from 540 ft. to 270 ft. Set plug at 270 ft. and cemented with 35 sacks cement. Filled hole with heavy rotary mud from 270 ft. to 40 ft. Set solid plug at 40 ft. and cemented to cellar with 12 sacks cement, 3 sacks cement in rat hole.


Plugging operations accomplished utilizing Sun Oil Well cementing pump truck through 4 1/2 inch drill pipe.

(If additional description is necessary, use BACK of this sheet)

Name of Plugging Contractor Sun Oilwell Cementing, Inc.
Box 169, Great Bend, Kansas 67530

STATE OF Kansas COUNTY OF Sedgwick, ss.
Merle Britting, Agent ~~XXXXXX~~ of owner ~~XXXXXX~~
of the above-described well, being first duly sworn on oath, says: That I have knowledge of the facts, statements, and matters herein contained and the log of the above-described well as filed and that the same are true and correct. So help me God.

(Signature) Merle Britting
200 North Main, Wichita, Ks. 67202
(Address)

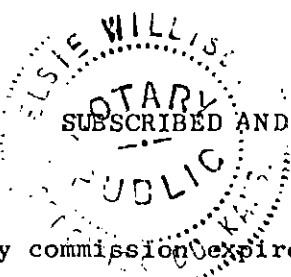

SUBSCRIBED AND SWORN TO before me this 17th day of August, 1978
My commission expires July 25, 1982
Elsie Willison
STATE CORPORATION COMMISSION Notary Public.

AUG 18 1978
CONSERVATION DIVISION
Wichita, Kansas

KANSAS DRILLERS LOG

COMPANY Murfin Drilling Company

SEC. 4 T. 22S R. 12W

FARM Stargel

NO. 1

LOC. C - NE NE NE

COUNTY Stafford

ROTARY TOTAL DEPTH 3,730'

COMM. August 4, 1978

COMP. August 12, 1978

CONTRACTOR H-30, Inc.

ISSUED August 17, 1978

CASING

10 3/4"

8 5/8" Set at 350' cemented w/275 sxs cement

ELEVATION 1,855 K.B.

5 1/2"

4 1/2"

FIGURES INDICATE BOTTOM OF FORMATIONS

| | |
|--------------------|--------|
| Sand | 240' |
| Red Bed | 352' |
| Red Bed and Shale | 700' |
| Shale and Shells | 1,440' |
| Shale and Lime | 1,690' |
| Lime and Shale | 3,678' |
| Lime | 3,730' |
| Rotary Total Depth | 3,730' |

I hereby certify the above and foregoing to be a true and correct log of the above described well as shown by the drilling reports.

H-30, Inc.

Merle Britting
Merle Britting

State of Kansas)
County of Sedgwick) ss:

Subscribed and Sworn to before me a Notary Public in and for said county and state this 17th day of August, 1978.

Elsie Willison
Elsie Willison - Notary Public

My Commission Expires:

July 25, 1982

RECEIVED
STATE CORPORATION COMMISSION

AUG 18 1978

CONSERVATION DIVISION
Wichita, Kansas