

PR

STATE OF KANSAS
STATE CORPORATION COMMISSION

Form CP-4

Give All Information Completely
Make Required Affidavit
Mail or Deliver Report to:
Conservation Division
State Corporation Commission
211 No. Broadway
Wichita, Kansas

WELL PLUGGING RECORD

Stafford County, Sec. 4 Twp. 22S Rge. 12 (X) (W)

Location as "NE/CNW/SW" or footage from lines NW NE SW

Lease Owner Western Petroleum Co., Inc.

Lease Name Sittner Well No. 1

Office Address Box 65, Great Bend, Kansas

Character of Well (completed as Oil, Gas or Dry Hole) Oil

Date well completed June 28 1961

Application for plugging filed January 18 1966

Application for plugging approved January 19 1966


Plugging commenced January 19 1966

Reasoning completed January 26 1966

Reason for abandonment of well or producing formation no longer economical to produce

If a producing well is abandoned, date of last production August 1965

Was permission obtained from the Conservation Division or its agents before plugging was commenced? Yes

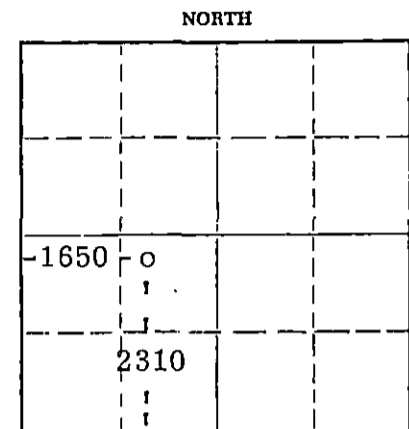

Locate well correctly on above Section Plat

Name of Conservation Agent who supervised plugging of this well A. Elving, Box 248, Pratt, Kansas

Producing formation Kansas City Depth to top 3442' Bottom 3483' Total Depth of Well 3510 Feet

Show depth and thickness of all water, oil and gas formations.

OIL, GAS OR WATER RECORDS

CASING RECORD

FORMATION	CONTENT	FROM	TO	SIZE	PUT IN	PULLED OUT
				8-5/8	286	None
				5-1/2	3638	2510'
Kansas City		3442'	3483'			

Describe in detail the manner in which the well was plugged, indicating where the mud fluid was placed and the method or methods used in introducing it into the hole. If cement or other plugs were used, state the character of same and depth placed, from _____ feet to _____ feet for each plug set.

Sand from 3510' to 3442', spotted 10 sacks cement. Heavy laden mud to 270', spotted 25 sacks cement, heavy laden mud to 20', filled pipe to base of collar with 10 sacks cement.

RECEIVED
STATE CORPORATION COMMISSION

JAN 31 1966

CONSERVATION DIVISION
Wichita, Kansas

1-31-66

(If additional description is necessary, use BACK of this sheet)

Name of Plugging Contractor Forbes Casing Pulling, Inc.

Address Great Bend, Kansas

STATE OF KANSAS COUNTY OF BARTON, ss.

Lavern S. Brown (employee of owner) or (~~owner or operator~~) of the above-described well, being first duly sworn on oath, says: That I have knowledge of the facts, statements, and matters herein contained and the log of the above-described well as filed and that the same are true and correct. So help me God.

(Signature) Lavern S. Brown

Box 65, Great Bend, Kansas
(Address)

SUBSCRIBED AND SWORN TO before me this 28th day of January, 1966

Elaine F. Bentley
Notary Public.

My commission expires 2/11/68

DRILLERS LOG

<u>COMPANY:</u>	WESTERN PETROLEUM CO., INC.	<u>LOCATION:</u>	NW NE SW, SEC. 4-225-12W STAFFORD COUNTY, KANSAS
<u>CONTRACTOR:</u>	WESTERN PETROLEUM CO., INC.	<u>ELEVATION:</u>	1867 KB
<u>FARM NAME:</u>	SITTNER	<u>CASING USED:</u>	8-5/8" AT 286' w/250 SX POZMIX # 3 SX C.C. # 3 SX A.C. 5-1/2" AT 3638' w/100 SX 50-50 POZMIX, 25 JELL
<u>COMMENCED:</u>	JUNE 12, 1961		
<u>COMPLETED:</u>	JUNE 21, 1961		

CLAY AND SAND	80
SAND	95
SHALE AND SAND	195
SHALE	287
RED BED	663
ANHYDRITE	684
SHALE AND SHELLS	1150
SHALE AND LIME	1530
LIME w/SHALE STREAKS	1695
LIME AND SHALE	2072
SHALE AND LIME	2841
LIME AND SHALE	3294
LIME	3470
LIME AND SHALE	3542
VIOLA	3567
CHERT AND SHALE	3605
ARBUCKLE	3639
ROTARY TOTAL DEPTH	3639

RECEIVED
STATE CORPORATION COMMISSION

APR 19 1966

CONSERVATION DIVISION
Wichita, Kansas

STATE OF KANSAS }
 } SS
COUNTY OF BARTON }

I, THE UNDERSIGNED, BEING DULY SWORN ON OATH, STATE THAT THE ABOVE STATEMENT AND LOG ARE TRUE AND A CORRECT RECORD AND LOG OF THE WELL DRILLED AT THE LOCATION ABOVE MENTIONED.

WESTERN PETROLEUM CO., INC.

John H. Volosin
JOHN H. VOLOSIN, GENERAL MANAGER

SUBSCRIBED AND SWORN TO BEFORE ME THIS 24TH DAY OF JUNE, 1961

Reva C. Brown
REVA C. BROWN, NOTARY PUBLIC

MY COMMISSION EXPIRES: JANUARY 15, 1963