

STATE OF KANSAS  
STATE CORPORATION COMMISSION

WELL PLUGGING RECORD


OR

FORMATION PLUGGING RECORD

Strike out upper line  
when reporting plug-  
ging off formations.

Give All Information Completely  
Make Required Affidavit  
Mail or Deliver Report to:  
Conservation Division  
State Corporation Commission  
800 Bitting Building  
Wichita, Kansas

NORTH

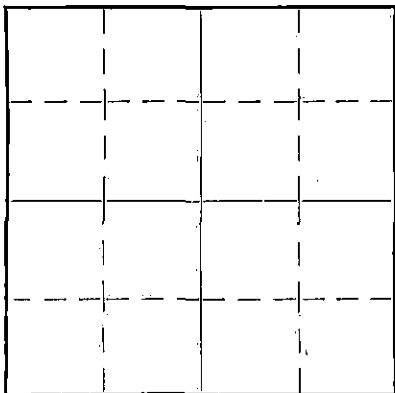

Locate well correctly on above  
Section Plat


Location as "*NE 1/4 NW 1/4 SW 1/4*" or footage from lines  
Lease Owner *W. H. Caspaker*  
Lease Name *Paul E. Litzner* Well No. *Wichita 14*  
Office Address *407 Union Natl Bldg Bldg. Wichita, Kas*  
Character of Well (Completed as Oil, Gas or Dry Hole) *Dry hole*  
Date, well completed *March 9 - 1938* 193. *8*  
Application for plugging filed *Feb. 14 -* 193. *8*  
Application for plugging approved *Feb. 14 -* 193. *8*  
Plugging Commenced *Feb. 15 -* 193. *8*  
Plugging Completed *March 9 -* 193. *8*  
Reason for abandonment of well or producing formation *Dry hole*

If a producing well is abandoned, date of last production 193  
Was permission obtained from the Conservation Division or its agents before plugging was commenced?

Name of Conservation Agent who supervised plugging of this well *yes B. J. Alexander + Mr. Feil.*  
Producing formation *Siliceous Lime* Depth to top *3685* Bottom *3700* Total Depth of Well *3700* Feet.  
Show depth and thickness of all water, oil and gas formations.

OIL, GAS OR WATER RECORDS


CASING RECORD

| Formation   | Content         | From        | To          | Size       | Put In      | Pulled Out  |
|-------------|-----------------|-------------|-------------|------------|-------------|-------------|
| <i>Lime</i> | <i>Show oil</i> | <i>3685</i> | <i>3696</i> | <i>13"</i> | <i>226</i>  | <i>None</i> |
|             |                 |             | <i>9</i>    | <i>7"</i>  | <i>3684</i> | <i>1450</i> |

Describe in detail the manner in which the well was plugged, indicating where the mud fluid was placed and the method or methods used in introducing it into the hole. If cement or other plugs were used, state the character of same and depth placed, from *250* feet to *cement* feet for each plug set.

*Filled hole with mud to 2800 feet.*  
*Put 15 sacks of cement in bridge at 250 feet.*  
*Put plug in top of surface pipe and cement plug of 10 sacks. Cementing surface pipe and collar.*

PLUGGING  
FILE SEC *4-22-126*  
BOOK PAGE *7* LINE *33*

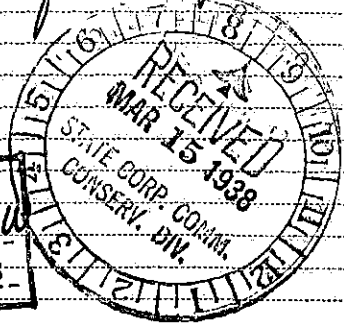

*3-15-38*

(If additional description is necessary, use BACK of this sheet)  
Address *407 Union National Bldg Bldg. Wichita, Kansas*

STATE OF \_\_\_\_\_, COUNTY OF \_\_\_\_\_, ss.

\_\_\_\_\_, (employee of owner) or (owner or operator) of the above-described well, being first duly sworn on oath, says: That I have knowledge of the facts, statements, and matters herein contained and the log of the above-described well as filed and that the same are true and correct. So help me God.

(Signature) *Geo. O. Wentworth*

(Address)

SUBSCRIBED AND SWORN to before me this *14* day of *March*, 19 *38*

My commission expires *July 3-1939*

*Paul Root*  
Notary Public.