


STATE OF KANSAS
STATE CORPORATION COMMISSION

WELL PLUGGING RECORD

Give All Information Completely
Make Required Affidavit
Mail or Deliver Report to:
Conservation Division
State Corporation Commission
800 Biting Building
Wichita, Kansas

Stafford County, Sec. 4 Twp. 22 Rge. (E) 12 (W)
Location as "NE/CNW/SW" or footage from lines SE NE SW
Lease Owner ANSCHUTZ DRILLING CO., INC.
Lease Name SI TTNER Well No. 1
Office Address 1019 Central Bldg., Wichita 2, Kansas
Character of Well (completed as Oil, Gas or Dry Hole) Oil
Date well completed 6-2- 19 51
Application for plugging filed 7-20- 19 56
Application for plugging approved 7-20- 19 56
Plugging commenced 7-24- 19 56
Plugging completed 7-27- 19 56
Reason for abandonment of well or producing formation Depleted

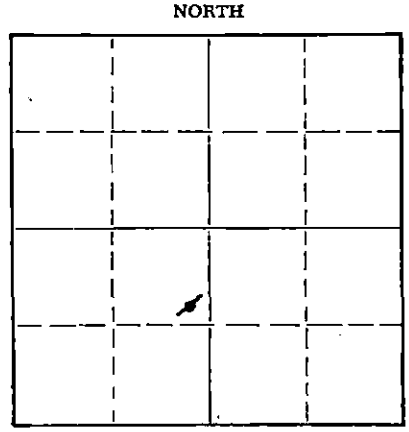

Locate well correctly on above Section Plat

If a producing well is abandoned, date of last production 7-10- 19 56
Was permission obtained from the Conservation Division or its agents before plugging was commenced? Yes

Name of Conservation Agent who supervised plugging of this well R. M. Brundage
Producing formation Arbuckle Depth to top 3647 Bottom Total Depth of Well 3649 Feet
Show depth and thickness of all water, oil and gas formations.

OIL, GAS OR WATER RECORDS

CASING RECORD

FORMATION	CONTENT	FROM	TO	SIZE	PUT IN	PULLED OUT
Arbuckle	Oil	3648	3649	8-5/8" OD	264'	150'
				5-1/2" OD	3648	2914

Describe in detail the manner in which the well was plugged, indicating where the mud fluid was placed and the method or methods used in introducing it into the hole. If cement or other plugs were used, state the character of same and depth placed, from feet to feet for each plug set.

3700 - 3636' - sand
3636 - 3600' - 5 sacks cement
3600 - 250' - mud
250 - 240 - rock bridge
180 - 35 - mud
35 - cellar - 10 sacks cement.

Note: Plugger reports T.D. at 3700'. We have no record of well being deeper than 3649'. 2-10-56

RECEIVED
STATE CORPORATION COMMISSION
AUG 1 1956
CONSERVATION DIVISION
WICHITA, KANSAS

(If additional description is necessary, use BACK of this sheet)
Name of Plugging Contractor R & S Pipe Pulling Company
Address Ellinwood, Kansas

STATE OF KANSAS, COUNTY OF SEDGWICK, ss. Agent
John W. Ritchey (employee of owner) or (owner or operator) of the above-described well, being first duly sworn on oath, says: That I have knowledge of the facts, statements, and matters herein contained and the log of the above-described well as filed and that the same are true and correct. So help me God.

(Signature) John W. Ritchey
1019 Central Bldg., Wichita 2, Kansas (Address)

SUBSCRIBED AND SWORN TO before me this 3rd day of August, 19 56

My commission expires April 23, 1958
Maurice C. Murphy Notary Public.

PLUGGING
FILE SEC 4 T 22 R 12W
BOOK PAGE 82 LINE 19

ANSCHUTZ DRILLING COMPANY, INC.

#1 Sittner SE NE SW 4-22-12
Stafford County, Kansas

271	400	Red shale
400	500	Red shale
500	660	Red bed
660	700	Anhydrite
700	820	Shale
820	860	Shale
860	1050	Salt, shale & streak of anhydrite
1050	1265	Shale
1265	1560	Shale & lime
1560	1685	Lime & shale
1685	1720	Shale & lime
1720	1732	Cherty beds broken
1732	1751	Broken lime
1751	1810	Lime streaks & shale
1810	1950	Shale & lime
1950	2060	Shale & lime
2060	2165	Lime
2165	2285	Lime & shale
2285	2445	Lime & shale
2445	2655	Shale
2655	2815	Shale & lime
2815	2890	Shale & lime
2890	3025	Lime
3025	3110	Lime
3110	3154	Lime
3154	3225	Lime
3225	3300	Shale & lime
3300	3355	Lime & shale
3355	3405	Lime
3405	3427	Lime
3427	3455	Lime
3455	3515	Lime
3515	3578	Lime & shale
3578	3586	Lime, cherty shale
3586	3620	Simpson
3620	3650	Lime
3650		Total Depth

COMMENCED: 5/28/51
COMPLETED: 6/26/51

ELEVATION: 1865 IF

TOPS:

- Heeb 3116
- Brown Line 3280
- Lansing 3292
- Congl 3518
- Simpson 3591
- Arb 3617

CASING RECORD

Set 3-5/8" surface casing at 264' with 150 sacks cement.
Set 5/8" oil string at 3648 with 135 sacks cement.

STATE OF KANSAS)
) SS
COUNTY OF SEDGWICK)

I hereby affirm that the above and foregoing is a true and correct copy of the log of the #1 Sittner located SE NE SW 4-22-12, Stafford County, Kansas.

ANSCHUTZ DRILLING COMPANY, INC.

BY: *H. R. Judd*

Subscribed and sworn to before me this 3rd day of July, 1951.

Notary Public

My commission expires January 21, 1954.

PLUGGING
FILE SEC 4 T 22 R 12W
BOOK PAGE 82 LINE 19

RECEIVED
STATE COMMISSION
AUG 1 1951
CONCRETE DIVISION