

STATE OF KANSAS  
STATE CORPORATION COMMISSION

WELL PLUGGING RECORD

Give All Information Completely  
Make Required Affidavit  
Mail or Deliver Report to  
Conservation Division  
State Corporation Comm.  
245 North Water  
Wichita, KS 67202

Stafford County, Sec. 5 Twp. 22s Rge. 12W E/W  
Location as "NE/CNW $\frac{1}{4}$ SW $\frac{1}{4}$ " or footage from lines  
SW NW NW


Lease Owner Arrowhead Petroleum, Inc.  
Lease Name Alpers Well No. 1  
Office Address Box 8287, Munger Station, Wichita, KS 67208  
Character of Well (Completed as Oil, Gas or Dry Hole) Dry Hole

Date Well completed 4-2-80 19  
Application for plugging filed 4-2-80 19  
Application for plugging approved 4-2-80 19  
Plugging commenced 4-2-80 19  
Plugging completed 4-2-80 19

Reason for abandonment of well or producing formation Dry Hole  
If a producing well is abandoned, date of last production N/A 19

Was permission obtained from the Conservation Division or its agents before plugging was commenced? yes

Name of Conservation Agent who supervised plugging of this well Wm. T. Owen  
Producing formation Depth to top Bottom Total Depth of Well  
Show depth and thickness of all water, oil and gas formations.

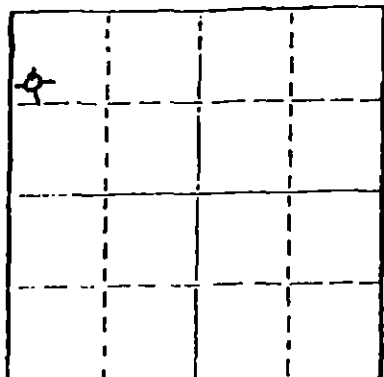

Locate well correctly on above Section Plot

OIL, GAS OR WATER RECORDS

CASING RECORD

FORMATION	CONTENT	FROM	TO	SIZE	PUT IN	PULLED OUT
Sand				8 5/8"	293'	None

Describe in detail the manner in which the well was plugged, indicating where the mud fluid was placed and the method or methods used in introducing it into the hold. If cement or other plugs were used, state the character of same and depth placed, from feet to feet for each plug set.

35 sx 540  
35 sx 300  
10 sx 40  
10 sx RH  
2 sx WW

RECEIVED  
APR - 4 1980  
CONSERVATION DIVISION  
STATE CORPORATION COMMISSION

(If additional description is necessary, use BACK of this sheet)

Name of Plugging Contractor Service Company

STATE OF Kansas COUNTY OF Sedgwick, ss.  
Paul A. Seymour, Jr. (employee of owner) or (owner or operator)  
of the above-described well, being first duly sworn on oath, says: That I have knowledge of the facts, statements, and matters herein contained and the log of the above-described well as filed and that the same are true and correct. So help me God.

(Signature) Paul A. Seymour, Jr.  
Box 8287, Munger Station, Wichita, KS 67208  
(Address)

SUBSCRIBED AND SWORN TO before me this 3rd day of April, 1980

RUTH M. BASSETT  
STATE NOTARY PUBLIC  
Sedgwick County, Kansas  
My commission expires May 30, 1983

Ruth M. Bassett  
Ruth M. Bassett Notary Public.

My commission expires

# BIG SPRINGS DRILLING, INC.

P.O. BOX 8287  
MUNGER STATION  
WICHITA, KANSAS 67208

SUITE 29 • 400 NORTH WOODLAWN • (316) 681-1732

April 3, 1980

## DRILLERS LOG

Re: Alpers No. 1  
SW NW NW  
Sec. 5-Twp 22s-Rq 12W  
Stafford County, Kansas

OPERATOR: Arrowhead Petroleum, Inc.  
CONTRACTOR: Big Springs Drilling, Inc.  
COMMENCED: 2-26-80  
COMPLETED: 3-2-80

Surface Pipe: 293' of 8 5/8" w/250 sx Common 2% gel 3% ccl

0	293	Sand, Clay, Shale
293	678	Clay and Shale
678	700	Anhydrite
700	2625	Shale
2625	3370	Lime and Shale
3370	3658	Lime
3658		RTD

RECEIVED  
STATE CORPORATION COMMISSION

APR - 4 1980

CONSERVATION DIVISION  
Wichita, Kansas

We certify that the above and foregoing is a true and correct copy of the log on the # 1 Alpers located in Stafford County, Kansas.

BIG SPRINGS DRILLING, INC.


  
Paul A. Seymour, Jr.

Subscribed and sworn to before me this 3rd day of April, 1980.

My Commission Expires Sedgwick County, Kansas

RUTH M. BASSETT  
STATE NOTARY PUBLIC  
My Appt. Exp. ....

May 30, 1983

  
Ruth M. Bassett Notary Public