


STATE OF KANSAS  
STATE CORPORATION COMMISSION

WELL PLUGGING RECORD

Give All Information Completely  
Make Required Affidavit  
Mail or Deliver Report to:  
Conservation Division  
State Corporation Commission  
800 Biting Building  
Wichita, Kansas

NORTH

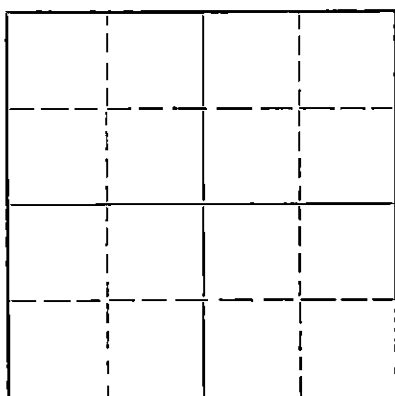

Locate well correctly on above  
Section Plat

Stafford County. Sec. 5 Twp. 22 Rge. (E) 12 (W)  
Location as "NE/CNW/SW" or footage from lines C. W/2 NE NE  
Lease Owner Petroleum, Inc.  
Lease Name Hainke Well No. 1  
Office Address 305 East Third, Wichita 2, Kansas  
Character of Well (completed as Oil, Gas or Dry Hole) Dry Hole  
Date well completed July 22, 1953  
Application for plugging filed July 22, 1953  
Application for plugging approved July 22, 1953  
Plugging commenced July 22, 1953  
Plugging completed July 22, 1953  
Reason for abandonment of well or producing formation Dry Hole

If a producing well is abandoned, date of last production 19  
Was permission obtained from the Conservation Division or its agents before plugging was commenced? Yes

Name of Conservation Agent who supervised plugging of this well Mr. M. A. Rives  
Producing formation \_\_\_\_\_ Depth to top \_\_\_\_\_ Bottom \_\_\_\_\_ Total Depth of Well 3677 Feet  
Show depth and thickness of all water, oil and gas formations.

OIL, GAS OR WATER RECORDS

CASING RECORD

FORMATION	CONTENT	FROM	TO	SIZE	PUT IN	PULLED OUT
				8 5/8"	240'	None

Describe in detail the manner in which the well was plugged, indicating where the mud fluid was placed and the method or methods used in introducing it into the hole. If cement or other plugs were used, state the character of same and depth placed, from \_\_\_\_\_ feet to \_\_\_\_\_ feet for each plug set.

Mudded up to 240' and set wooden plug at 240'. Placed 1/2 sack hulls on top of plug at 240'. Cemented and displaced 20 sacks cement through drill pipe on to plug at 240'.  
Mudded up to 40' and set second wooden plug at 40'. Placed 1/2 sack hulls on top of plug at 40'. Filled hole to bottom of well cellar with 10 sacks cement.

8-4-53

(If additional description is necessary, use BACK of this sheet)

Name of Plugging Contractor Garvey Drilling Company  
Address R. R. #2, Great Bend, Kansas

STATE OF KANSAS COUNTY OF SEDGWICK, ss.  
W. W. Fisher (employee of owner) of the above-described well, being first duly sworn on oath, says: That I have knowledge of the facts, statements, and matters herein contained and the log of the above-described well as filed and that the same are true and correct. So help me God.

(Signature) W. W. Fisher  
305 East Third, Wichita, Kansas  
(Address)

SUBSCRIBED AND SWORN to before me this 31st day of July, 1953

Charlotte Anderson  
Notary Public.

My commission expires October 13, 1954

PLUGGING  
FILED SEC 57 22 12W  
BOOK PAGE 117 LINE 36

DRILLER'S LOG HAINKE NO. 1

Petroleum, Inc., Operator

Section 5, Twp. 22S, Rge. 12W

Garvey Drilling Company, Contractor

Location: C. W/2 NE NE

Drilling Commenced: July 14, 1953

County: Stafford County, Kansas

Drilling Completed: July 23, 1953

Production: D & A

Casing Record: 8 5/8" @ 240' w/200 sax

Figures below indicate bottom of formation:

40 Surface and Sand  
 228 Sand, Shells & Shale  
 240 Red Rock & Shale  
 673 Shale & Shells  
 705 Anhydrite  
 1575 Shale & Shells  
 2200 Lime & Shale  
 2335 Shale  
 2550 Shale, Lime & Shells  
 3110 Lime & Shale  
 3547 Lime  
 3600 Lime & Shale  
 3606 Shale  
 3650 Lime & Shale  
 3677 Lime  
 3677 R.T.D.

Tops:

Heebner: 3160 (-1282)  
 Brown Lime: 3295 (-1417)  
 Lansing: 3310 (-1432)  
 Arbuckle: 3652 (-1774)

I hereby certify that this is a true and correct log of the above mentioned well.

PETROLEUM, INC.

RECEIVED  
STATE CORPORATION COMMISSION

By W.W. Tule

AUG - 4 1953

STATE OF KANSAS

CONSERVATION DIVISION  
SS: Wichita, Kansas

COUNTY OF SEDGWICK

Subscribed to and sworn to before me, a Notary Public, in said County and State, this 31st day of July, 1953.

Charlotte M...  
Notary Public

My commission expires: October 13, 1954

PLUGGING  
 FILE NO. 3-1227-120  
 BOOK PAGE 17 LINE 36