


WELL PLUGGING RECORD

Give All Information Completely  
Make Required Affidavit  
Mail or Deliver Report to:  
Conservation Division  
State Corporation Commission  
800 Bittling Building  
Wichita, Kansas

NORTH

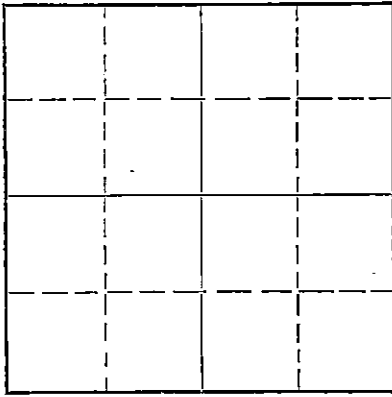

Locate well correctly on above  
Section Plat

Stafford County. Sec. 5 Twp. 22 Rge. 12 (X) (W)  
Location as "NE/CNW/SW" or footage from lines C S/2 SW SE  
Lease Owner Petroleum, Inc.  
Lease Name Teichmann 'C' Well No. 1  
Office Address 305 East Third, Wichita, Kansas  
Character of Well (completed as Oil, Gas or Dry Hole) Dry Hole  
Date well completed November 1, 1953  
Application for plugging filed November 1, 1953  
Application for plugging approved November 1, 1953  
Plugging commenced November 1, 1953  
Plugging completed November 1, 1953  
Reason for abandonment of well or producing formation Dry Hole

If a producing well is abandoned, date of last production 19  
Was permission obtained from the Conservation Division or its agents before plugging was commenced? Yes

Name of Conservation Agent who supervised plugging of this well Mr. M. A. Rives  
Producing formation \_\_\_\_\_ Depth to top \_\_\_\_\_ Bottom \_\_\_\_\_ Total Depth of Well 3701 Feet  
Show depth and thickness of all water, oil and gas formations.

OIL, GAS OR WATER RECORDS

CASING RECORD

FORMATION	CONTENT	FROM	TO	SIZE	PUT IN	PULLED OUT
				8 5/8"	248'	None

Describe in detail the manner in which the well was plugged, indicating where the mud fluid was placed and the method or methods used in introducing it into the hole. If cement or other plugs were used, state the character of same and depth placed, from \_\_\_\_\_ feet to \_\_\_\_\_ feet for each plug set.

Mudded up to 240' and set wooden plug at  
240'. Placed 1/4 sack hulls on top of  
plug at 240'. Cemented and displaced  
through drill pipe 20 sacks cement onto  
plug and hulls at 240'. Mudded up to 40'  
and placed second plug at 40'. Filled hole  
to bottom of well cellar with 10 sacks cement.

(If additional description is necessary, use BACK of this sheet)

Name of Plugging Contractor Garvey Drilling Company  
Address R.R. #2, Great Bend, Kansas

STATE OF KANSAS, COUNTY OF SEDGWICK, ss.  
W.W. Fisher (employee of owner) or (owner/operator) of the above-described well, being first duly sworn on oath, says: That I have knowledge of the facts, statements, and matters herein contained and the log of the above-described well as filed and that the same are true and correct. So help me God.

(Signature) W.W. Fisher  
305 East Third, Wichita, Kansas  
(Address)

SUBSCRIBED AND SWORN to before me this 12th day of November, 1953

My commission expires October 13, 1954

Shadrach Mendenhall  
Notary Public.

PLUGGING  
FILE SEC 5 T 22 R 126  
BOOK PAGE 40 LINE 42

RECEIVED  
STATE CORPORATION COMMISSION  
NOV 13 1953  
CONSERVATION DIVISION  
Wichita, Kansas

DRILLER'S LOG TEICHMANN 'C' #1

Petroleum, Inc., Operator

Section 5, Twp. 22S, Range 12W

Garvey Drilling Company, Contractor

Location: C S/2 SW SE

Drilling Commenced: October 22, 1953

County: Stafford County, Kansas

Drilling Completed: November 1, 1953

Production: D & A


Casing Record: 8 5/8" @ 248' w/200 sax

R.T.D.: 3701'

Figures below indicate bottom of formation:

120	Sand		
235	Shale & Sand		
248	Red Bed & Blue Shale	Heebner:	3188 (-1310)
675	Shale & Shells	Brown Lime:	3316 (-1444)
700	Anhydrite	Lansing:	3334 (-1462)
800	Red Bed, Sand & Shells	Conglomerate:	3584 (-1712)
820	Lime	Viola:	3588 (-1727)
1275	Shale & Shells	Simpson:	3677 (-1775)
1725	Shale	Arauckles:	3696 (-1824)
1960	Lime & Shale		
2195	Lime		
2450	Shale		
2710	Shale & Shells		
2905	Shale		
3589	Lime		
3647	Cherty Lime		
3670	Sand Stone		
3696	Lime & Shale		
3701	Lime		
3701	R.T.D.		

I hereby certify that this is a true and correct log of the above mentioned well.

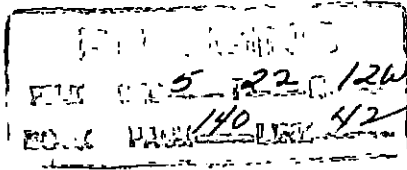

PETROLEUM, INC.

By W. W. Fish

STATE OF KANSAS )  
                          ) SS:  
COUNTY OF SEDGWICK)

Subscribed to and sworn to before me, a Notary Public, in said County and State, this 12th day of November, 1953.

Shelton Friedman  
Notary Public

My commission expires: October 13, 1954