


Give All Information Completely
Make Required Affidavit
Mail or Deliver Report to:
Conservation Division
State Corporation Commission
212 North Market, Insurance Bldg.
Wichita, Kansas

WELL PLUGGING RECORD

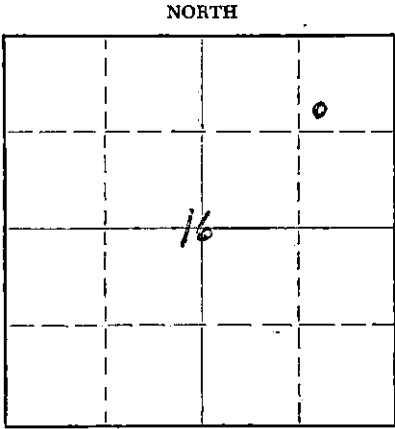

Locate well correctly on above Section Plat

Stafford County. Sec. 16 Twp. 22^S Rge. 12 (EX) (W)
Location as "NE/CNW/SW" or footage from lines SW NE NE
Lease Owner WILKINSON DRILLING, INC.
Lease Name Ringing Well No. 1
Office Address 805 Union Center Bldg., Wichita 2, Kansas
Character of Well (completed as Oil, Gas or Dry Hole) Dry Hole
Date well completed February 10 19 60
Application for plugging filed February 10 19 60
Application for plugging approved February 10 19 60
Plugging commenced February 10 19 60
Plugging completed February 10 19 60
Reason for abandonment of well or producing formation Dry Hole

If a producing well is abandoned, date of last production _____ 19____
Was permission obtained from the Conservation Division or its agents before plugging was commenced? yes

Name of Conservation Agent who supervised plugging of this well Frank Broadfoot
Producing formation _____ Depth to top _____ Bottom _____ Total Depth of Well 3678' Feet
Show depth and thickness of all water, oil and gas formations.

OIL, GAS OR WATER RECORDS

CASING RECORD

FORMATION	CONTENT	FROM	TO	SIZE	PUT IN	PULLED OUT
Sand	water	30	80			

Describe in detail the manner in which the well was plugged, indicating where the mud fluid was placed and the method or methods used in introducing it into the hole. If cement or other plugs were used, state the character of same and depth placed, from _____ feet to _____ feet for each plug set.

Fill hole with heavy mud, plug @ 240' topped with 1/4 sack of hulls and 20 sacks cement through drill pipe. Mud to 35', plug, 1/4 sack of hulls and 10 sacks cement.

STATE CORPORATION COMMISSION

FEB 16 1960

CONSERVATION DIVISION
Wichita, Kansas

2-16-60

(If additional description is necessary, use BACK of this sheet)
Name of Plugging Contractor WILKINSON DRILLING, INC.
Address 805 Union Center Bldg., Wichita 2, Kansas

STATE OF KANSAS, COUNTY OF SEDGWICK, ss.
Walter M. Wilkinson (Employee or owner or (owner or operator) of the above-described well, being first duly sworn on oath, says: That I have knowledge of the facts, statements, and matters herein contained and the log of the above-described well as filed and that the same are true and correct. So help me God.

(Signature) Walter M. Wilkinson

805 Union Center Bldg., Wichita 2, Kans.
(Address)

SUBSCRIBED AND SWORN TO before me this 12 th day of February, 19 60

My commission expires January 2, 1961

Carolyn K. Moore
Carolyn K. Moore Notary Public.



WILKINSON DRILLING, INC.
805 Union Center Building
Wichita 2, Kansas

February 12, 1960

RINGERING #1

Company - WILKINSON DRILLING, INC.
Contractor - Company Tools
Commenced - February 1, 1960
Completed - February 10, 1960
Total Depth - 3678'
Location - SW NE NE, Sec. 16-22^S-12^W, Stafford County, Kansas
Elevation - 1865' KB
Casing - 8 5/8" @ 252' w/275 sacks

FIGURES INDICATE BOTTOMS OF FORMATIONS

<u>Depth</u>	<u>Formations</u>
0 - 40	Surface soil and sand.
40-- 252	Sand, clay and shale.
252 - 1590	Shale and shells.
1590 - 3148	Lime and shale.
3148 - 3153	Shale.
3153 - 3180	Lime and shale streaks.
3180 - 3281	Shale and sandy shale.
3281 - 3286	Lime.
3286 - 3300	Shale.
3300 - 3508	Lime and shale streaks.
3508 - 3554	Shale and lime stringers.
3554 - 3558	Vari-colored chert.
3558 - 3611	Chert-fresh to tripolitic.
3611 - 3619	Shale.
3619 - 3639	Sand and Shale.
3639 - 3673	Shale and lime streaks.
3673 - 3678	ARBUCKLE, dolomite.

RECEIVED
STATE CORPORATION COMMISSION
FEB 16 1960
CONSERVATION DIVISION
Wichita, Kansas

We hereby certify the above and foregoing to be a true and correct copy of the Log on the Ringing #1, located in the SW NE NE, Sec. 16-22^S-12^W, Stafford County, Kansas.

WILKINSON DRILLING, INC.

Walter M. Wilkinson

Subscribed and sworn to before me this twelfth day of February, nineteen hundred and sixty.

Carolyn K. Moore
Carolyn K. Moore

My commission expires January 2, 1961.