


Give All Information Completely  
Make Required Affidavit  
Mail or Deliver Report to:  
Conservation Division  
State Corporation Commission  
211 No. Broadway  
Wichita, Kansas

WELL PLUGGING RECORD

NORTH

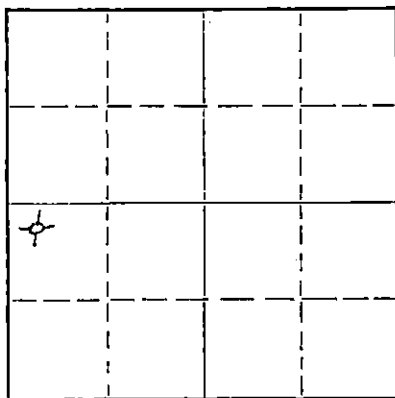

Locate well correctly on above Section Plat

Stafford County, Sec. 16 Twp. 22S Rge. 12 ~~XX~~ (W)  
Location as "NE/CNWxSWx" or footage from lines NW NW SW  
Lease Owner R. W. Shields  
Lease Name Spangenberg Well No. 1  
Office Address 308 Rule Building, Wichita, Kansas  
Character of Well (completed as Oil, Gas or Dry Hole) Dry hole  
Date well completed August 1, 19 59  
Application for plugging filed July 31, 19 59  
Application for plugging approved July 31, 19 59  
Plugging commenced August 1, 19 59  
Plugging completed August 1, 19 59  
Reason for abandonment of well or producing formation Dry hole

If a producing well is abandoned, date of last production \_\_\_\_\_ 19\_\_\_\_  
Was permission obtained from the Conservation Division or its agents before plugging was commenced? Yes

Name of Conservation Agent who supervised plugging of this well Don Truan  
Producing formation \_\_\_\_\_ Depth to top \_\_\_\_\_ Bottom \_\_\_\_\_ Total Depth of Well 3790 Feet  
Show depth and thickness of all water, oil and gas formations.

OIL, GAS OR WATER RECORDS

CASING RECORD

FORMATION	CONTENT	FROM	TO	SIZE	PUT IN	PULLED OUT
		0	255'	8 5/8"	255	None

Describe in detail the manner in which the well was plugged, indicating where the mud fluid was placed and the method or methods used in introducing it into the hole. If cement or other plugs were used, state the character of same and depth placed, from \_\_\_\_\_ feet to \_\_\_\_\_ feet for each plug set.

- From 3790' to 241 1/2' - Heavy rotary mud
- " 241 1/2' to 240' - Wooden Plug
- " 240' to 148' - 1/2 sack hulls and 30 sacks cement (through drill pipe)
- " 148' to 41 1/2' - Heavy rotary mud
- " 41 1/2' to 40' - Wooden Plug
- " 40' to 6' - 1/2 sack hulls and 10 sacks cement
- " 6' to surface - 3 sacks cement

8-25-59

**RECEIVED**  
STATE CORPORATION COMMISSION  
AUG 25 1959  
CONSERVATION DIVISION  
Wichita, Kansas

(If additional description is necessary, use BACK of this sheet)

Name of Plugging Contractor \_\_\_\_\_  
Address \_\_\_\_\_

STATE OF Kansas, COUNTY OF Sedgwick, ss.  
William Herbert (employee of owner) or (owner or operator) of the above-described well, being first duly sworn on oath, says: That I have knowledge of the facts, statements, and matters herein contained and the log of the above-described well as filed and that the same are true and correct. So help me God.

(Signature) William Herbert  
R. R. #3, Box 144B, Wichita 15, Kansas  
(Address)

SUBSCRIBED AND SWORN TO before me this 22nd day of August, 19 59

Marion M. Herbert  
Notary Public.

My commission expires March 4, 1962.

**PLUGGING**  
 FILE SEC. 16 T. 22 R. 12W  
 BOOK PAGE 63 LINE 8

DRILLER'S LOG

Company: R. W. Shields

Loc.: NW NW SW  
Sec. 16 Twp. 22S Rge. 12W

Farm: Soangenberg Well No. 1

County: Stafford,  
Kansas

Total Depth: 3790'

Elevation:

Comm.: 7-21-59 Comp.: 8-1-59

Contractor: Glenn W. Peel Drilling Company

Casing: 8 5/8" @ 255' Cem.

Production: Dry

Figures below indicate bottom of formations

Sand	0	to	40
Sand and shale			255
Red bed			660
Anhydrite			690
Shale			1180
Sand			1400
Shale and lime			1500
Lime			1970
Lime and shale			2515
Shale w/lime streaks			2680
Lime and shale			2870
Lime			3185
Lime and shale			3310
Lime			3595
Chert and lime			3670
Lime			3790
Total Depth			3790

This is to certify that the above information is, to the best of my knowledge, true and correct.

GLENN W. PEEL DRILLING COMPANY

BY: *Glenn W. Peel*

SUBSCRIBED AND SWORN TO before me this 22nd of August, 1959.

My commission expires March 4, 1962

*Marion M. Herbert*  
Notary Public

RECEIVED  
STATE OF KANSAS

AUG 25 1959

CONSERVATION DIVISION  
Wichita, Kansas

PLUGGING  
FILE SEC. 16 T. 22 N. 20  
BOOK PAGE 63 LINE 8