

STATE OF KANSAS
STATE CORPORATION COMMISSION

WELL PLUGGING RECORD

Give All Information Completely
Make Required Affidavit
Mail or Deliver Report to:
Conservation Division
State Corporation Commission
800 Bittling Building
Wichita, Kansas

Stafford County. Sec. 16 Twp. 22S Rge. (E) 12(W)

Location as "NE/CNW%SW%" or footage from lines NE NW NW

Lease Owner Petroleum, Inc.

Lease Name Steineke Well No. 1

Office Address 305 East Third, Wichita, Kansas

Character of Well (completed as Oil, Gas or Dry Hole) Dry Hole

Date well completed April 27, 1953

Application for plugging filed April 27, 1953

Application for plugging approved April 27, 1953


Plugging commenced April 27, 1953

Plugging completed April 27, 1953

Reason for abandonment of well or producing formation Dry Hole

If a producing well is abandoned, date of last production 19

Was permission obtained from the Conservation Division or its agents before plugging was commenced? Yes

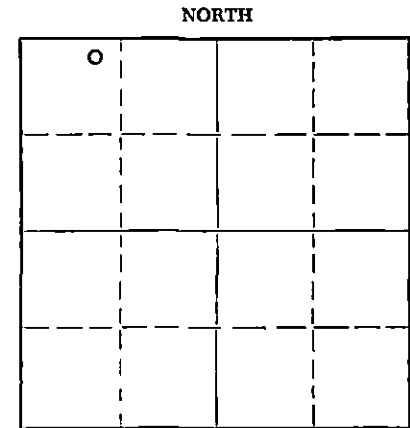

Locate well correctly on above
Section Plat

Name of Conservation Agent who supervised plugging of this well Mr. M. A. Rives

Producing formation Depth to top Bottom Total Depth of Well 3705 Feet

Show depth and thickness of all water, oil and gas formations.

OIL, GAS OR WATER RECORDS

CASING RECORD

FORMATION	CONTENT	FROM	TO	SIZE	PUT IN	PULLED OUT
				8 5/8"	230'	None

Describe in detail the manner in which the well was plugged, indicating where the mud fluid was placed and the method or methods used in introducing it into the hole. If cement or other plugs were used, state the character of same and depth placed, from feet to feet for each plug set.

Mudded up to 210' and set wooden plug at 210'.

Cemented and displaced 20 sacks cement through
drill pipe onto plug at 210'. Mudded up to 35'
and set second wooden plug. Filled hole to
bottom of well cellar with 10 sacks cement.

5-5-53

(If additional description is necessary, use BACK of this sheet)

Name of Plugging Contractor Garvey Drilling Company

Address R. R. #2, Great Bend, Kansas

STATE OF KANSAS, COUNTY OF SEDGWICK, ss.
W. W. Fisher (employee of owner) ~~XXXXXX~~ of the above-described

well, being first duly sworn on oath, says: That I have knowledge of the facts, statements, and matters herein contained and the log of the above-described well as filed and that the same are true and correct. So help me God.


(Signature) W. W. Fisher

305 East Third, Wichita, Kansas
(Address)

SUBSCRIBED AND SWORN TO before me this 30th day of April, 1953

Charlotte Friedman
Notary Public.

My commission expires October 13, 1954

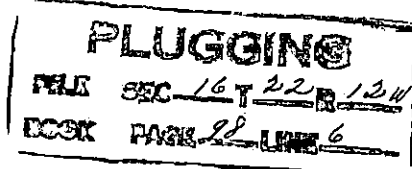

DRILLER'S LOG STEINEKE NO. 1

Petroleum, Inc., Operator

Section 16, Twp. 22S, Rge. 12W

Garvey Drilling Company, Contractor

Location: NE NW NW

Drilling Commenced: April 18, 1953

County: Stafford County, Kansas

Drilling Completed: April 27, 1953

R.T.D.: 3705'

Casing Record: 8 5/8" @ 230' w/175 sax

Production: D & A

Figures below indicate bottom of formation:

40 Surface soil
 160 Sand
 215 Coarse Sand
 230 Shale & Red Bed
 665 Red Bed
 695 Anhydrite
 990 Shale & Shells
 1300 Red Bed & Shale
 1555 Salt, Shale & Shells
 1780 Lime & Shale
 2105 Lime
 2500 Lime & Shale
 2675 Shale
 2987 Lime & Shale
 3055 Sandy Shale
 3180 Lime
 3250 Lime & Shale
 3337 Lime, Shale
 3569 Lime
 3577 Conglomerate
 3628 Viola chert
 3691 Shale
 3705 Shale & Lime
 3705' R.T.D.

Tops:

Heebner: 3159 (-1289)
 Brown Lime: 3296 (-1426)
 Lansing: 3313 (-1443)
 Conglomerate: 3565 (-1695)
 Viola: 3577 (-1707)
 Simpson: 3631 (-1761)
 Arbuckle: 3690 (-1820)

I hereby certify that this is a true and correct log of the above mentioned well.

PLUGGING

FILE SEC 16 T 22 R 12W
 BOOK PAGE 28 LINE 6

STATE OF KANSAS)

COUNTY OF SEDGWICK)

RECEIVED
 STATE COMMISSION

MAY 15 1953

CONSERVATION DIVISION
 Wichita, Kansas

SS:

PETROLEUM, INC.

By wwt

Subscribed to and sworn to before me, a Notary Public, in said County and state, this 30th day of April, 1953.

My commission expires: October 13, 1954.

Charlotte Heron
 Notary Public