

15-185-30319-0000

Form CP-4


STATE OF KANSAS
STATE CORPORATION COMMISSION

Give Information Completely
Make Required Affidavit
Mail or Deliver Report to:
Conservation Division
State Corporation Commission
212 No. Market
Wichita, Kansas

WELL PLUGGING RECORD

Stafford County, Sec. 2 Twp. 23 Rge. 13 (E) (W)

Location as "NE/CNW/SW" or footage from lines N/2 NW SW
Lease Owner E. K. Edmiston
Lease Name Bliss Well No. #2
Office Address 425 First National Bank Bldg., Wichita, Kansas
Character of Well (completed as Oil, Gas or Dry Hole) _____
Date well completed _____ 19____
Application for plugging filed _____ 19____
Application for plugging approved _____ 19____
Plugging commenced 3-12-68 19____
Plugging completed 3-16-68 19____
Reason for abandonment of well or producing formation _____

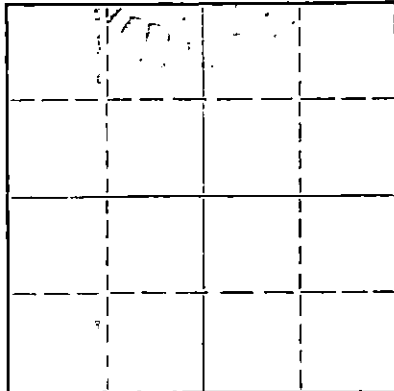

Locate well correctly on above
Section Flat

If a producing well is abandoned, date of last production _____ 19____
Was permission obtained from the Conservation Division or its agents before plugging was commenced? _____

Name of Conservation Agent who supervised plugging of this well Herman Justus
Producing formation _____ Depth to top _____ Bottom _____ Total Depth of Well 3840' Feet
Show depth and thickness of all water, oil and gas formations.

OIL, GAS OR WATER RECORDS

CASING RECORD

FORMATION	CONTENT	FROM	TO	SIZE	PUT IN	PULLED OUT
				4 1/2"	3836'	3135.46'
				8 5/8"	275'	

Describe in detail the manner in which the well was plugged, indicating where the mud fluid was placed and the method or methods used in introducing it into the hole. If cement or other plugs were used, state the character of same and depth placed, from _____ feet to _____ feet for each plug set.

Made bottom hole plug back with sand to 3800'. Mixed and ran 4 sacks cement thru dump bailer.
Squeezed hole with 15 sacks gel, followed with 90 sacks cement. Cement from 475' to 200'. Followed with 3 sacks gel. Gel from 200' to 30'. Displaced with 10 sacks cement. Cement from 30' to base of cellar.

RECEIVED
STATE CORPORATION COMMISSION
MAR 19 1968
CONSERVATION DIVISION
Wichita, Kansas

3-19-68

(If additional description is necessary, use BACK of this sheet)


Name of Plugging Contractor Southwest Casing Pulling Co., Inc.
Address Box 364, Great Bend, Kansas

STATE OF Kansas, COUNTY OF Barton, ss.
Southwest Casing Pulling Co., Inc. (employee of owner) or (owner or operator) of the above-described well, being first duly sworn on oath, says: That I have knowledge of the facts, statements, and matters herein contained and the log of the above-described well as filed and that the same are true and correct. So help me God.

(Signature) H. C. Spencer Sec.
Box 364, Great Bend, Kansas
(Address)

SUBSCRIBER AFFIDAVIT TO before me this 18 day of March, 19 68

My commission expires October 1968

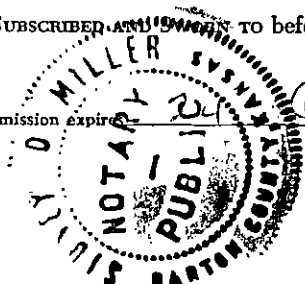

Sidney Miller
Notary Public.

15.185-30 319-0000

DRILLER'S LOG

Company: E. K. Edmiston
 425 First National Bank Building
 Wichita, Kansas 67202

Rotary Drilling Commenced: October 24, 1966

Rotary Drilling Completed: November 1, 1966

Well Name: BLISS No. 2
 N/2 NW/4 SW/4 2-23S-13W
 Stafford County, Kansas

Contractor: E. K. Edmiston Drilling Co., Inc.
 425 First National Bank Building
 Wichita, Kansas 67202

Casing Record: 8-5/8" at 276' with 250 sacks
 4 1/2" at 3836' with 75 sacks

L O G

Measurements from top of rotary bushing

Lime and Shale	0 - 276
Red Bed and Shale	737
Anhydrite	759
Shale	1821
Lime and Shale	2245
Shale and Lime	3210
Lime	3747
Chert and Lime	3789
Lime	3840 RTD

RECEIVED
 STATE CORPORATION COMMISSION
 MAR 11 1968
 CONSERVATION DIVISION
 Wichita, Kansas

The undersigned, E. K. Edmiston, President of E. K. Edmiston Drilling Co., Inc., hereby certifies on behalf of said company, that the above log is a true and correct log of the formations encountered in drilling the above well, as reflected by the daily drilling reports.

E. K. EDMISTON DRILLING CO., INC.

By [Signature]
E. K. Edmiston, President

STATE OF KANSAS,
 SS:
 SEDGWICK COUNTY,

BE IT REMEMBERED that on this 8th day of November, 1966, before me, the undersigned, a Notary Public within and for the county and state aforesaid, came E. K. Edmiston, known to me to be the same person who executed the foregoing instrument as President and on behalf of the E. K. Edmiston Drilling Co., Inc., and he duly acknowledged the execution of the same for himself and for said company.

IN WITNESS WHEREOF, I have hereunto set my hand and official seal on the day and year last above written.

[Signature]
A. B. Bargaen, Notary Public

My commission expires
 August 25, 1968

