


15-185-01458-0000

WELL PLUGGING RECORD

All Information Completely  
Required Affidavit  
or Deliver Report to:  
Conservation Division  
State Corporation Commission  
211 No. Broadway  
Wichita, Kansas

STAFFORD County. Sec. 2 Twp. 23s Rge. 13W (EX (W)  
NE SE SE

NORTH

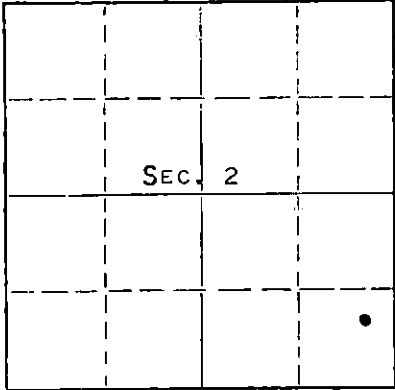

Locate well correctly on above  
Section Plat

Location as "NE/CNW/SW" or footage from lines  
Lease Owner PETROLEUM, INC.  
Lease Name KELLY "B" Well No. 1  
Office Address ROUTE 2, GREAT BEND, KANSAS  
Character of Well (completed as Oil, Gas or Dry Hole) DRY HOLE  
Date well completed FEBRUARY 28, 19 63  
Application for plugging filed FEBRUARY 28, 19 63  
Application for plugging approved FEBRUARY 28, 19 63  
Plugging commenced FEBRUARY 28, 19 63  
Plugging completed FEBRUARY 28, 19 63  
Reason for abandonment of well or producing formation NO PRODUCIBLE ZONES

If a producing well is abandoned, date of last production NONE 19  
Was permission obtained from the Conservation Division or its agents before plugging was commenced? YES

Name of Conservation Agent who supervised plugging of this well ARCHIE ELVING  
Producing formation --- Depth to top --- Bottom --- Total Depth of Well 3875 Feet  
Show depth and thickness of all water, oil and gas formations.

OIL, GAS OR WATER RECORDS

CASING RECORD

FORMATION	CONTENT	FROM	TO	SIZE	PUT IN	PULLED OUT
				8-5/8"	255.53	NONE

Describe in detail the manner in which the well was plugged, indicating where the mud fluid was placed and the method or methods used in introducing it into the hole. If cement or other plugs were used, state the character of same and depth placed, from feet to feet for each plug set.

MUDDED UP WITH HEAVY MUD TO 180' FOLLOWED BY 1/4 SACK HULLS AND WOODEN PLUG.  
PLACED 20 SACKS CEMENT THROUGH DRILL PIPE ONTO PLUG. MUDDED UP WITH HEAVY MUD  
TO 40' FOLLOWED BY 1/4 SACK HULLS, WOODEN PLUG AND 10 SACKS CEMENT TO BASE OF WELL  
CELLAR. PLUG RAT HOLE WITH 2 SACKS CEMENT.

STATE CORPORATION COMMISSION

MAR 5 1963

CONSERVATION DIVISION  
Wichita, Kansas

3-5-63

(If additional description is necessary, use BACK of this sheet)  
Name of Plugging Contractor GARVEY DRILLING COMPANY  
Address ROUTE 2, GREAT BEND, KANSAS

STATE OF KANSAS, COUNTY OF BARTON, ss.  
DON SEARLE (employee of owner) or (owner) of the above-described well, being first duly sworn on oath, says: That I have knowledge of the facts, statements, and matters herein contained and the log of the above-described well as filed and that the same are true and correct. So help me God. DON SEARLE, DIST. PROD. SUPT.  
(Signature) Don Searle  
ROUTE 2, GREAT BEND, KANSAS (Address)

SUBSCRIBED AND SWORN to before me this 4TH day of MARCH, 19 63

My commission expires APRIL 14, 1963 Notary Public.



# WELL LOG

15-185-0458-0000

COMPANY Petroleum Inc.

SEC. 2 T. 23SR. 13W

FARM Kelly

NO. B-1

LOC. NE SE SE


TOTAL DEPTH 3875'

COUNTY Stafford

COMM. 2-18-63

COMP. 2-28-63

CONTRACTOR Garvey Drilling Company

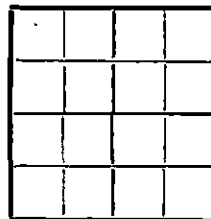

CASING 8 5/8" @ 255.53' w/200 SX

ELEVATION 1861' DF

PRODUCTION D & A

FIGURES INDICATE BOTTOM OF FORMATIONS

- 223' Sand and Gravel
- 230' Shale
- 256' Shale and Shells
- 725' Red Bed and Shale
- 750' Anhydrite
- 1240' Red Bed, Shale and Shells
- 1565' Shale and Shells
- 1705' Lime and Shale
- 2145' Shale and Lime
- 2300' Lime and Shale
- 3453' Shale and Lime
- 3675' Lime
- 3730' Lime and Shale
- ~~3730'~~
- 3785' Lime (Cherty
- 3807' Cherty Lime and Sand
- 3860' Simpson
- 3875' Arbuckle
- 3875' RTD

RECEIVED  
STATE CORPORATION

MAR 5 1963

CONSERVATION DIVISION  
Wichita, Kansas

State of Kansas }  
County of Barton } ss

I, Sam N. Stephens of Garvey Drilling Company

upon oath state the above and foregoing is a true and correct copy of the log of the Kelly B-1 well.

Sam N. Stephens

Subscribed and sworn to before me this 1st day of March 19 63

My Commission Expires: April 14th, 1963

Archer J. Nile  
NOTARY PUBLIC