

15-185-00817-0001

STATE OF KANSAS
STATE CORPORATION COMMISSION

Form CP-4

Give All Information Completely
Make Required Affidavit
Mail or Deliver Report to:
Conservation Division
State Corporation Commission
212 No. Market
Wichita, Kansas 67202

WELL PLUGGING RECORD

Stafford County, Sec. 2 Twp. 23 Rge. 13W (E) (W)
Location as "NE/CNW/SW" or footage from lines NW SE NW


Lease Owner Harry Sprague
Lease Name Mawhirter Well No. I
Office Address Bx 348 Mc Pherson, Kansas 67460

Character of Well (completed as Oil, Gas or Dry Hole) oil
Date well completed 12-23 19 55
Application for plugging filed 7-24 19 70
Application for plugging approved 7-25 19 70
Plugging commenced 8-13 19 70
Plugging completed 8-28 19 70

Reason for abandonment of well or producing formation

If a producing well is abandoned, date of last production 19

Was permission obtained from the Conservation Division or its agents before plugging was commenced? Yes

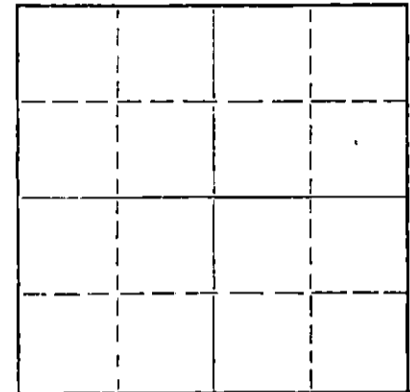

Locate well correctly on above Section Plat

Name of Conservation Agent who supervised plugging of this well B. R. Biberstein

Producing formation Depth to top Bottom Total Depth of Well 3850' Feet

Show depth and thickness of all water, oil and gas formations.

OIL, GAS OR WATER RECORDS

CASING RECORD

FORMATION	CONTENT	FROM	TO	SIZE	PUT IN	PULLED OUT
			5 1/2"			1,904'

Describe in detail the manner in which the well was plugged, indicating where the mud fluid was placed and the method or methods used in introducing it into the hole. If cement or other plugs were used, state the character of same and depth placed, from feet to feet for each plug set.

Plugged off bottom of hole with sand. San from 3646' to 3500'. Dumped 5 bx of cement. Pumped 15 bx of mud and 100 bx of cement, with Allied Cementing Co..

RECEIVED
STATE CORPORATION COMMISSION
SEP 1 1970
CONSERVATION DIVISION
Wichita, Kansas

(If additional description is necessary, use BACK of this sheet)

Name of Plugging Contractor Art Lamb Casing Pulling Co.
Address 2809 King St. Hutchinson, Kansas 67501

STATE OF Kansas, COUNTY OF Reno, ss.

(employee of owner) or (owner or operator) of the above-described well, being first duly sworn on oath, says: That I have knowledge of the facts, statements, and matters herein contained and the log of the above-described well as filed and that the same are true and correct. So help me God.

(Signature) Art Lamb
2809 King Hutchinson
(Address)

SUBSCRIBED AND SWORN TO before me this 28th day of August, 19 70

My commission expires Jan 5, 1974
Judy Lamb
Notary Public.

15-185-00817-0000

WELL LOG BUREAU - KANSAS GEOLOGICAL SOCIETY
503 East Murdock, Wichita, Kansas


COPY

Company- GREENLAND DRILLING CO.
Farm- Mawhitzer No. 1

SEC. 2 T. 23 R. 13W
NW SE. NW

Total Depth. 3850'
Comm. 12-19-55 Comp. 12-23-55
Shot or Treated.
Contractor. Greenland Drlg.
Issued: 3-10-56

County Stafford
KANSAS

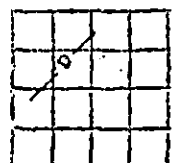

CASING:
8 5/8" 252'
5 1/2" 3848 W 150' x 4'

Elevation. 1866' RB

Production. Dry

Figures Indicate Bottom of Formations.

top soil	6
sand	192
shale & shells	252
red bed	726
anhydrite	748
shale & shells	1250
salt, shale & shells	1525
shale & lime	1635
lime & shale	2335
shale & lime	3030
lime & shale	3155
lime	3215
lime & shale	3249
shale	3253
lime & shale	3370
shale & lime	3430
lime	3646
shale & lime	3660
lime	3688
lime, shale w/chert	3711
chert	3767
lime (cherty)	3786
sandy shale	3794
Dolomite	3820
Arbuckle	3836
lime	3850
Total Depth	
Tops:	
Heebner	3248
Brown Lime	3383
Lansing	3405
Viola	3720
Simpson Shale	3766
Simpson Dolomite	3793
Arbuckle	3820

RECEIVED
STATE CORPORATION COMMISSION
JUL 27 1970
CONSERVATION DIVISION
Wichita, Kansas