


STATE OF KANSAS
STATE CORPORATION COMMISSION

Form CP-4

WELL PLUGGING RECORD

Give All Information Completely
Make Required Affidavit
Mail or Deliver Report to:
Conservation Division
State Corporation Commission
212 No. Market
Wichita, Kansas

NORTH

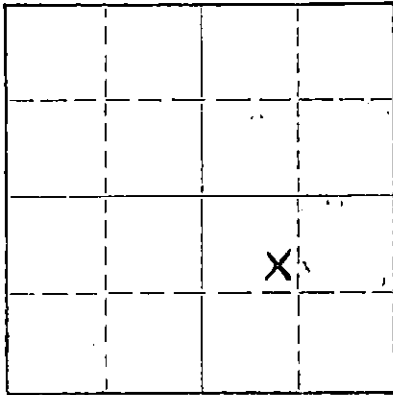

Locate well correctly on above
Section Plat

Stafford County. Sec. 12 Twp. 22S Rge. 12 (E) W (W)
Location as "NE/CNW/SW" or footage from lines SE NW SE
Lease Owner Joe Brougher Oil Co.
Lease Name Willinger Well No. #2
Office Address 5513 Apache Great Bend, Kansas 67530
Character of Well (completed as Oil, Gas or Dry Hole) _____
Date well completed _____ 19____
Application for plugging filed April 1970
Application for plugging approved April 1970
Plugging commenced April 29 1970
Plugging completed May 2 1970
Reason for abandonment of well or producing formation _____

If a producing well is abandoned, date of last production _____ 19____
Was permission obtained from the Conservation Division or its agents before plugging was commenced? Yes

Name of Conservation Agent who supervised plugging of this well Russell Biberstein
Producing formation _____ Depth to top _____ Bottom _____ Total Depth of Well _____ Feet
Show depth and thickness of all water, oil and gas formations.

OIL, GAS OR WATER RECORDS

CASING RECORD

FORMATION	CONTENT	FROM	TO	SIZE	PUT IN	PULLED OUT
				8 5/8	200	None
				5 1/2	3578	3011

Describe in detail the manner in which the well was plugged, indicating where the mud fluid was placed and the method or methods used in introducing it into the hole. If cement or other plugs were used, state the character of same and depth placed, from _____ feet to _____ feet for each plug set.

April 29, 1970 Plugged off bottom. Dumped sand to 3500'. Mixed and dumped 5 sx of cement to 3460'.
May 2, 1970 Plugged off top. Globe Oil Well Cementing Co. mixed and pumped down 8 5/8" surface casing: 1 sx hulls, 15 sx of gel, released plug and mixed and pumped 100 sx of cement.

RECEIVED
STATE CORPORATION COMMISSION
JUN 23 1970
CONSERVATION DIVISION
Wichita, Kansas

6-23-70

Name of Plugging Contractor RUSS CASING PULLING, INC. (If additional description is necessary, use BACK of this sheet)
Address P. O. Box 1082 Great Bend, Kansas 67530


STATE OF Kansas, COUNTY OF Barton, ss.
Joe Brougher (executor, administrator, or operator) of the above-described well, being first duly sworn on oath, says: That I have knowledge of the facts, statements, and matters herein contained and the log of the above-described well as filed and that the same are true and correct. So help me God.

(Signature) Joe Brougher
5513 Apache, Great Bend, Kansas
(Address)

SUBSCRIBED AND SWORN to before me this 8th day of July, 1970

My commission expires August 11, 1970.

Joann Skolaut
Joann Skolaut Notary Public.

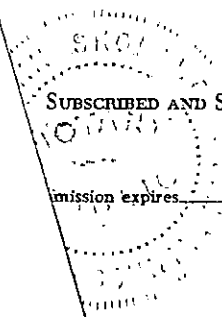

Joe Brougher Oil Company
Willinger #2

SE NW SE Sec. 12-22S-12W
Stafford County, Kansas

Elevation: 1799 RB; 1796 DF; 1794 Ground

GEOLOGICAL TOPS

<u>FORMATION</u>	<u>DEPTH</u>	<u>SUB-SEA</u>	<u>THICKNESS</u>
Anhydrite	552-572	+1247-+1227	20' Driller
Heebner Shale	3070	-1271	4'
Brown Lime	3200	-1401	4'
Lansing-KansasCity	3226	-1427	
Conglomerate	3476	-1677	222'
Viola	3498	-1699	27'
Simpson Shale	3525	-1726	25'
Simpson Sand	3550	-1751	5'
Arbuckle	3577	-1778	
5½" Casing	3578	-1779	
R. T. D.	3581	-1782	

RECEIVED
STATE CORPORATION COMMISSION
APR 28 1970
CONSERVATION DIVISION
Wichita, Kansas