


WELL PLUGGING RECORD

Give All Information Completely  
Make Required Affidavit  
Mail or Deliver Report to:  
Conservation Division  
State Corporation Commission  
211 No. Broadway  
Wichita, Kansas

NORTH

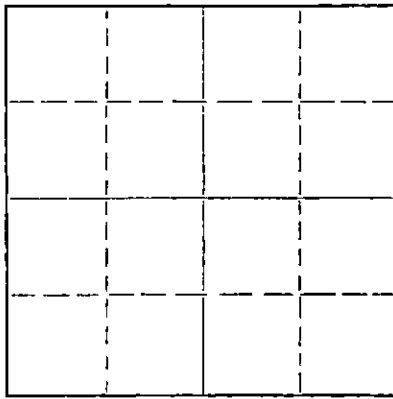

Locate well correctly on above  
Section Plat

Stafford County. Sec. 12 Twp. 22S Rge. 12W (~~EX~~) (W)  
Location as "NE/CNW/SW" or footage from lines C NE of NW  
Lease Owner Graham-Michaelis Drilling Company  
Lease Name Wokaty Well No. 3  
Office Address 211 North Broadway Wichita, Kansas  
Character of Well (completed as Oil, Gas or Dry Hole) Oil  
Date well completed 10-11-51 19  
Application for plugging filed 2-27-57 19  
Application for plugging approved 3-4-57 19  
Plugging commenced 2-27-57 19  
Plugging completed 3-3-57 19  
Reason for abandonment of well or producing formation Low Production

If a producing well is abandoned, date of last production 10-30-56 19  
Was permission obtained from the Conservation Division or its agents before plugging was commenced? Yes

Name of Conservation Agent who supervised plugging of this well Russell Brundage-1101 Hoisington, Kansas  
Producing formation \_\_\_\_\_ Depth to top \_\_\_\_\_ Bottom \_\_\_\_\_ Total Depth of Well 3597 Feet  
Show depth and thickness of all water, oil and gas formations.

OIL, GAS OR WATER RECORDS

CASING RECORD

FORMATION	CONTENT	FROM	TO	SIZE	PUT IN	PULLED OUT
Sand, Red Clay & Lime		0'	175'	8 5/8"	175'	0'
Shale, Red Rock, Anhy., Shells, Lime						
Sand, Arbuckle		176'	3597'	5 1/2"	3596'	2724'

Describe in detail the manner in which the well was plugged, indicating where the mud fluid was placed and the method or methods used in introducing it into the hole. If cement or other plugs were used, state the character of same and depth placed, from \_\_\_\_\_ feet to \_\_\_\_\_ feet for each plug set.

Plugged back with sand from 3595' to 3550' and dumped 5 sacks cement.  
Pulled casing. Mudded hole to 195', set rock bridge from 195' to 185'  
and dumped 25 sacks cement. Mud to 20', set rock bridge from 20' to 15'  
and poured 5 sacks cement to base of cellar.

3-9-57

RECEIVED  
STATE CORPORATION COMMISSION

MAR 9 - 1957

CONSERVATION  
Wichita

(If additional description is necessary, use BACK of this sheet)

Name of Plugging Contractor Ace Pipe Pulling Company  
Address Box 304 - Great Bend, Kansas

STATE OF KANSAS, COUNTY OF SEDGWICK, ss.  
V. D. Grier (employee of owner) or (owner or operator) of the above-described

well, being first duly sworn on oath, says: That I have knowledge of the facts, statements, and matters herein contained and the log of the above-described well as filed and that the same are true and correct. So help me God. Graham-Michaelis Drilling Co.

(Signature) V. D. Grier

211 North Broadway Wichita, Kansas  
(Address)

SUBSCRIBED AND SWORN to before me this 8th day of March, 19 57

My commission expires 1/11/61

Charlotte S. Wall  
Notary Public.  
CHARLOTTE S. WALL,


PLUGGING  
FILE SEC. 12 T. 22 R. 12W  
BOOK PAGE 144 LINE 41

WELL LOG BUREAU--KANSAS GEOLOGICAL SOCIETY  
508 East Murdock, Wichita, Kansas

Company- D. M. SHAWVER-WM. GRAHAM OIL CO.  
Farm- Wokaty No. 3

SEC. 12 T. 22 R. 12W  
SW NE NW  
810' fr. EL, 990'  
fr. NL  
County Stafford  
KANSAS

Total Depth. 3607  
Comm. 10-8-51 Comp. 10-11-51  
Shot or Treated.  
Contractor. Laura Jane Oil Co., Inc.  
Issued. 12-29-51

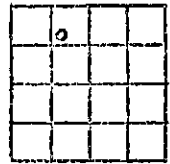

CASING:  
8 5/8" 175'  
5 1/2" 3596

Elevation. 1822 DE

Production. 2 bbls. per hr.  
natural

Figures Indicate Bottom of Formations.

sand	130
red clay	150
sand, lime	175
shale, red rock	425
red rock	465
anhydrite	500
shale, shells	1645
Ft. Riley lime	1700
lime	1815
shale, lime	2935
sand	2970
shale, lime	3077
lime	3128
lime, shale	3243
lime	3593
arbuckle	3597 RTD
arbuckle	3607
Total depth	

Tops:  
Heebner shale 3087  
Br. lime 3217  
K. C. lime 3243  
Viola chert 3503  
Simpson 3538  
Arbuckle dolomite 3595

RECEIVED  
STATE CORPORATION COMMISSION

MAR 9 - 1957  
CONSERVATION DIVISION  
Wichita, Kansas

PLUGGING  
FILE SEC. 12 T. 22 R. 12W  
BOOK PAGE 144 LINE 41

RECEIVED  
MAR 10 1957  
Laura Jane Oil Co.