


STATE OF KANSAS
STATE CORPORATION COMMISSION

Give All Information Completely
Make Required Affidavit
Mail or Deliver Report to:
Conservation Division
State Corporation Commission
211 No. Broadway
Wichita, Kansas

WELL PLUGGING RECORD

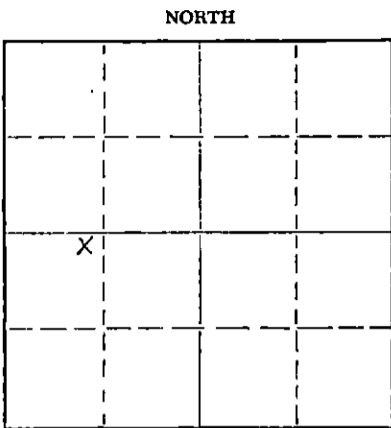

Locate well correctly on above Section Plat

Stafford County, Sec. 12 Twp. 22 Rge. 12 ~~EX~~ (W)
Location as "NE/CNW/SW" or footage from lines NE NW SW
Lease Owner H. C. Bennett
Lease Name Voight Well No. 4
Office Address 1212 Union National Bldg., Wichita, Kansas
Character of Well (completed as Oil, Gas or Dry Hole) oil well
Date well completed 4-5-52 19
Application for plugging filed 10-22-65 19
Application for plugging approved 10-25-65 19
Plugging commenced 11-12-65 19
Plugging completed 11-15-65 19
Reason for abandonment of well or producing formation depleted

If a producing well is abandoned, date of last production 19
Was permission obtained from the Conservation Division or its agents before plugging was commenced? yes

Name of Conservation Agent who supervised plugging of this well Archie Elving
Producing formation _____ Depth to top _____ Bottom _____ Total Depth of Well 3614 Feet
Show depth and thickness of all water, oil and gas formations.

OIL, GAS OR WATER RECORDS

CASING RECORD

FORMATION	CONTENT	FROM	TO	SIZE	PUT IN	PULLED OUT
				8 5/8	195	none
				5 1/2	3610	2513

Describe in detail the manner in which the well was plugged, indicating where the mud fluid was placed and the method or methods used in introducing it into the hole. If cement or other plugs were used, state the character of same and depth placed, from _____ feet to _____ feet for each plug set.

Fill hole with chat from 3614' to 3600' and dump 5 sacks cement.
Set 10' rock bridge from 195' to 185' and dump 2 sacks calseal on bridge. Let calseal set for 2 hrs. Bailed hole dry to bridge and dump 25 sacks cement. Mud hole to 40', rock bridge to 30' and dump 10 sacks cement.

RECEIVED
STATE CORPORATION COMMISSION
NOV 24 1965
CONSERVATION DIVISION
WICHITA, KANSAS

(If additional description is necessary, use BACK of this sheet)
Name of Plugging Contractor Flint Engineering & Construction Company
Address Box 950, El Dorado, Kansas

STATE OF KANSAS, COUNTY OF BUTLER, ss.

(employee of owner) or (owner or operator) of the above-described well, being first duly sworn on oath, says: That I have knowledge of the facts, statements, and matters herein contained and the log of the above-described well as filed and that the same are true and correct. So help me God.

(Signature) Paul Bowdle
El Dorado, Kansas
(Address)

SUBSCRIBED AND SWORN TO before me this 23rd day of November, 19 65

My commission expires 9-27-67
Ronald R. Hawman
Notary Public.

COPY

WELL LOG BUREAU—KANSAS GEOLOGICAL SOCIETY

500 East Murdock, Wichita, Kansas


H. C. Bennett

Company- NORTHERN PUMP CO.
Farm- Voigt No. 4

SEC. 12 T. 22 R. 12W
NE NW SW

Total Depth. 3614
Comm. 3-1-52 Comp. 4-5-52
Shot or Treated.
Contractor. Buick Drlg. Co.
Issued. 6-28-52

County Stafford
KANSAS

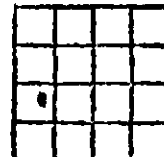

Elevation. 1828 ft

Production. 120 bbls.

CASING:

8 5/8" 195' cem. w/150 sx
5 1/2" 3610' cem. w/150 sx

Figures Indicate Bottom of Formations.

sand & clay	70
sand & gravel	105
shale	155
red bed	600
anhydrite	625
shale & shells	935
shale, shells, & salt	1510
shale & lime	1695
lime broken	1850
lime & shale	2945
lime	3135
shale	3230
shale & lime	3280
lime	3315
lime & shale	3410
lime	3535
lime & shale	3612 RTD
lime & shale	3614
Total Depth	

Tops:	
Anhydrite	600
Heobner Shale	3096
Brown Lime	3224
Lansing	3248
Viola (Chert)	3516
Simpson (Shale)	3551
Arbuckle	3609

RECEIVED
STATE CORPORATION COMMISSION
NOV 24 1965
CONSERVATION DIVISION
Wichita, Kansas