


STATE OF KANSAS
STATE CORPORATION COMMISSION

Form CP-4

WELL PLUGGING RECORD

Give All Information Completely
Make Required Affidavit
Mail or Deliver Report to:
Conservation Division
State Corporation Commission
211 No. Broadway
Wichita, Kansas

NORTH

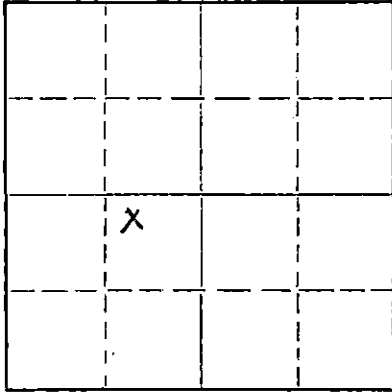

Locate well correctly on above
Section Plat

Stafford County. Sec. 12 Twp. 22 Rge. 12 (E)X(X) (W)
Location as "NE/CNW/SW" or footage from lines NW NE SW
Lease Owner H. C. Bennett
Lease Name Voight Well No. 3
Office Address 1212 Union National Bldg., Wichita, Kansas
Character of Well (completed as Oil, Gas or Dry Hole) oil well
Date well completed 12-21-51 19
Application for plugging filed 10-22-65 19
Application for plugging approved 10-24-65 19
Plugging commenced 11-8-65 19
Plugging completed 11-12-65 19
Reason for abandonment of well or producing formation depleted

If a producing well is abandoned, date of last production 19
Was permission obtained from the Conservation Division or its agents before plugging was commenced? yes

Name of Conservation Agent who supervised plugging of this well Archie Elving
Producing formation _____ Depth to top _____ Bottom _____ Total Depth of Well 3611 Feet
Show depth and thickness of all water, oil and gas formations.

OIL, GAS OR WATER RECORDS

CASING RECORD

FORMATION	CONTENT	FROM	TO	SIZE	PUT IN	PULLED OUT
				8 5/8	233	none
				5 1/2	3605	2653

Describe in detail the manner in which the well was plugged, indicating where the mud fluid was placed and the method or methods used in introducing it into the hole. If cement or other plugs were used, state the character of same and depth placed, from _____ feet to _____ feet for each plug set.

Fill hole with chat from 3619' to 3600' and dump 5 sacks cement.
Set 10' rock bridge from 230' to 220' and mix and dump 4 sacks cement. Let cement set overnight. Bail hole down to 220' and dump 21 sacks cement. Mud hole to 40', rock bridge to 30' and dump 10 sacks cement.

RECEIVED
STATE CORPORATION COMMISSION

NOV 18 1965

11-18-65

CONSERVATION DIVISION
Wichita, Kansas

(If additional description is necessary, use BACK of this sheet)
Name of Plugging Contractor Flint Engineering & Construction Company
Address Box 950, El Dorado, Kansas

STATE OF KANSAS, COUNTY OF BUTLER, ss.

(employee of owner) or (owner or operator) of the above-described well, being first duly sworn on oath, says: That I have knowledge of the facts, statements, and matters herein contained and the log of the above-described well as filed and that the same are true and correct. So help me God.

(Signature)

Laura Bawle

El Dorado, Kansas

(Address)

SUBSCRIBED AND SWORN TO before me this 16th day of November, 19 65

Ronald P. Hanson

Notary Public.

My commission expires

9-27-67

COPY


WELL LOG BUREAU—KANSAS GEOLOGICAL SOCIETY
508 East Murdock, Wichita, Kansas

Company. NORTHERN ORDNANCE INC.
Farm. Voight No. 3

SEC. 12 T. 22 R. 12W
NW NE SW

Total Depth. 3611
Comm. 11-20-51 Comp. 12-26-51
Shot or Treated.
Contractor. Northern Ordnance Inc.
Issued. 12-5-53

County Stafford
KANSAS

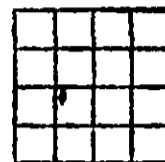

CASING:

8 5/8" 233' cem./w200 sx
5 1/2" 3605' com./w 110 sx

Elevation. 1827 DE

Production. 272 bbls. oil &
no wtr

Figures indicate Bottom of Formations.

sand & clay	40
sand	130
redbed & shale	400
sand & shale	500
shale, shells & sand streaks	765
shale & sand	790
Anhydrite	815
redbed, shale & shells	1100
shale & sand	1400
shale & shells	1700
shale & lime	2045
shale	2835
lime & shale	2885
lime	2930
lime & shale	3065
lime	3100
lime & shale	3299
lime	3344
lime & shale	3400
lime	3512
Conglomerate & lime cherty	3540
Simpson dolomite	3565
shale & lime	3570
shale & sand	3608, RTD
Oolitic lime	3611
Total depth	

Tops:	
Hebner shale	3104
Brown lime	3233
Lansing KC	3258
Conglomerate	3520
Viola	3526
Simpson	3550
Arbuckle	3604

RECEIVED
STATE CORPORATION COMMISSION

NOV 18 1965

CONSERVATION DIVISION
Wichita, Kansas