

STATE OF KANSAS
STATE CORPORATION COMMISSION


WELL PLUGGING RECORD

Give All Information Completely
Make Required Affidavit
Mail or Deliver Report to:
Conservation Division
State Corporation Commission
211 No. Broadway
Wichita, Kansas

Stafford County. Sec. 12 Twp. 22 Rge. 12 xxx (E) (W)

Location as "NE/CNW&SW" or footage from lines NE NE SW
Lease Owner H. C. Bennett
Lease Name Voight Well No. 2
Office Address 1212 Union National Bldg., Wichita, Kansas
Character of Well (completed as Oil, Gas or Dry Hole) oil well
Date well completed 7-9-51 19__
Application for plugging filed 10-22-65 19__
Application for plugging approved 10-24-65 19__
Plugging commenced 10-28-65 19__
Plugging completed 10-30-65 19__
Reason for abandonment of well or producing formation depleted

NORTH

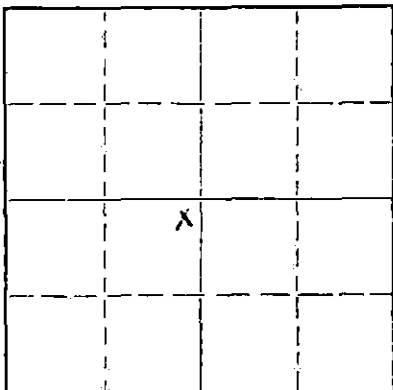

Locate well correctly on above Section Plat

If a producing well is abandoned, date of last production _____ 19__
Was permission obtained from the Conservation Division or its agents before plugging was commenced? yes

Name of Conservation Agent who supervised plugging of this well Archie Elving
Producing formation _____ Depth to top _____ Bottom _____ Total Depth of Well 3665 Feet
Show depth and thickness of all water, oil and gas formations.

OIL, GAS OR WATER RECORDS

CASING RECORD

| FORMATION | CONTENT | FROM | TO | SIZE | PUT IN | PULLED OUT |
|-----------|---------|------|----|-------|--------|------------|
| | | | | 8 5/8 | 215 | none |
| | | | | 5 1/2 | 3665 | 2722.08 |
| | | | | | | |
| | | | | | | |
| | | | | | | |
| | | | | | | |
| | | | | | | |
| | | | | | | |
| | | | | | | |

Describe in detail the manner in which the well was plugged, indicating where the mud fluid was placed and the method or methods used in introducing it into the hole. If cement or other plugs were used, state the character of same and depth placed, from _____ feet to _____ feet for each plug set.

Fill hole with sand from 3665' to 3600' and dump 5 sacks cement.
Set 10' rock bridge from 200' to 190' and mix and dump 4 sacks cement.
Let cement set up overnight. Bailed hole dry to 190' and dump 25 sacks cement. Mud hole to 40', set 10' rock bridge to 30' and dump 10 sacks cement.

11-4-65

RECEIVED
STATE CORPORATION COMMISSION

NOV 4 1965

CONSERVATION DIVISION
WICHITA, KANSAS

Name of Plugging Contractor Flint Engineering & Construction Company
Address Box 950, El Dorado, Kansas

STATE OF KANSAS, COUNTY OF BUTLER, ss.

(employee of owner) or (operator) of the above-described well, being first duly sworn on oath, says: That I have knowledge of the facts, statements, and matters herein contained and the log of the above-described well as filed and that the same are true and correct. So help me God.

(Signature) [Signature]
El Dorado, Kansas

SUBSCRIBED AND SWORN to before me this 3rd day of November, 19 65

[Signature]
Notary Public.

My commission expires 9-27-67

WELL LOG BUREAU—KANSAS GEOLOGICAL SOCIETY
508 East Murdock, Wichita, Kansas


COPY

Company. NORTHERN ORDNANCE INC. ET AL
Farm. Voight No. 2

SEC. 12 T. 22 R. 12W
NE NE SW

Total Depth. 3665
Comm. 6-26-51 Comp. 7-9-51
Shot or Treated.
Contractor. Hilton Drlg.
Issued. 9-29-51

County Stafford
KANSAS

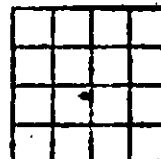

Elevation. 1823 K.B.

Production. 149 bbls. / 3% wtr.

CASING:

8 5/8" 215' cem. w/250 sx.
5 1/2" 3665' cem. w/125 sx.

Figures Indicate Bottom of Formations.

| | |
|--------------------------|------|
| sand, gravel & clay | 90 |
| clay | 120 |
| clay & s and | 166 |
| red bed | 215 |
| red bed & shells | 575 |
| red bed | 585 |
| anhyd. | 620 |
| shale & shells | 1285 |
| lime & shale | 1370 |
| lime brkn | 1695 |
| lime | 1745 |
| lime brkn | 1850 |
| lime | 1930 |
| lime & shale | 2215 |
| lime brkn & shale | 2390 |
| lime & shale | 2875 |
| lime | 3489 |
| lime, clay & cherty lime | 3531 |
| lime & chert | 3559 |
| congl. | 3595 |
| lime & Simpson shale | 3621 |
| Congl. | 3665 |
| Total Depth | |

| | |
|---------------|------|
| Tops: Scout | |
| Heebner | 3092 |
| Lansing | 3246 |
| Congl. | 3510 |
| Viola | 3520 |
| Simpson shale | 3551 |
| Simpson sand | 3610 |
| Arbuckle | 3619 |

RECEIVED
STATE CORPORATION COMMISSION

NOV 4 1965

CONSERVATION DIVISION
Wichita, Kansas