


STATE OF KANSAS
STATE CORPORATION COMMISSION

Give All Information Completely
Make Required Affidavit
Mail or Deliver Report to:
Conservation Division
State Corporation Commission
211 No. Broadway
Wichita, Kansas

WELL PLUGGING RECORD

NORTH

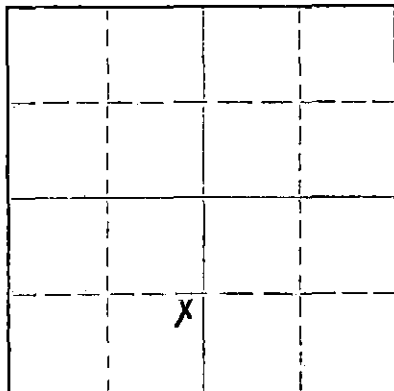

Locate well correctly on above
Section Plat

Stafford County. Sec. 12 Twp. 22 Rge. 12 (E) (W)
Location as "NE/CNW/SW" or footage from lines. NE SE SW
Lease Owner: H. C. Bennett
Lease Name: Voight Well No. 5
Office Address: 1212 Union National Bldg., Wichita, Kansas
Character of Well (completed as Oil, Gas or Dry Hole) oil well
Date well completed 11-3-56 19
Application for plugging filed 10-22-65 19
Application for plugging approved 10-24-65 19
Plugging commenced 11-1-65 19
Plugging completed 11-4-65 19
Reason for abandonment of well or producing formation depleted

If a producing well is abandoned, date of last production 19
Was permission obtained from the Conservation Division or its agents before plugging was commenced? yes

Name of Conservation Agent who supervised plugging of this well Archie Elving
Producing formation Depth to top Bottom Total Depth of Well 3613 Feet
Show depth and thickness of all water, oil and gas formations.

OIL, GAS OR WATER RECORDS

CASING RECORD

FORMATION	CONTENT	FROM	TO	SIZE	PUT IN	PULLED OUT
				8 5/8	168	none
				5 1/2	3609	2862.12

Describe in detail the manner in which the well was plugged, indicating where the mud fluid was placed and the method or methods used in introducing it into the hole. If cement or other plugs were used, state the character of same and depth placed, from feet to feet for each plug set.

Fill hole with chat from 3613' to 3600' and dump 5 sacks cement.
Set 15' rock bridge from 165' to 150' and mix and dump 4 sacks cement - let cement set overnight. Bail hole down to bridge and dump 25 sacks cement. Mud hole to 40', rock bridge to 30' and dump 10 sacks cement.

RECEIVED
STATE CORPORATION COMMISSION

NOV 15 1965

CONSERVATION DIVISION
Wichita, Kansas

(If additional description is necessary, use BACK of this sheet)
Name of Plugging Contractor Flint Engineering & Construction Company
Address Box 950, El Dorado, Kansas

STATE OF KANSAS, COUNTY OF BUTLER, ss.
(employee of owner) or (owner or operator) of the above-described well, being first duly sworn on oath, says: That I have knowledge of the facts, statements, and matters herein contained and the log of the above-described well as filed and that the same are true and correct. So help me God.

(Signature) *James Burdell*
El Dorado, Kansas
(Address)

SUBSCRIBED AND SWORN TO before me this 11th day of November, 19 65

Ronald R. Hanson
Notary Public.

COPY


WELL LOG BUREAU—KANSAS GEOLOGICAL SOCIETY
503 East Murdock, Wichita, Kansas

Company- NORTHERN PUMP COMPANY
Farm- Voight No. 5

SEC. 12 T. 22 R. 12W
NE SE SW

Total Depth. 3613'
Comm. 10-25-56 Comp. 11-3-56
Shot or Treated.
Contractor. Strata Drilling Co.
Issued. 12-22-56

County Stafford
KANSAS

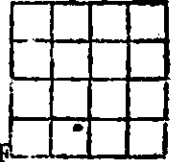

Elevation. 1822' DR

CASING:
8 5/8" @168' w/200 sx cem.
5 1/2" @3609' w/75 sx cem.

Production. 50 Bbls oil in
5 hours

Figures indicate Bottom of Formations.

sand & shale	170
shale	263
shale & shells	1005
Anhydrite Streaks	1075
shale & shells	1350
lime streaks	1475
shale & lime	1835
lime	1865
lime & shale	3400
lime	3570
lime & shale	3604 RTD
lime & shale	3613 CTTD
Total Depth	

TOPS	
Heebner	3095'
Brown Lime	3225
Lansing	3252
Chert Conglomerate	3514
Viola	3525
Simpson Shale	3551
Arbuckle	3607

Swabbed 50 bbls. oil in
5 hour test.

RECEIVED
STATE CORPORATION COMMISSION
NOV 15 1965
CONSERVATION DIVISION
Wichita, Kansas