


STATE OF KANSAS
STATE CORPORATION COMMISSION

WELL PLUGGING RECORD

Give All Information Completely
Make Required Affidavit
Mail or Deliver Report to:
Conservation Division
State Corporation Commission
212 No. Market
Wichita, Kansas

Stafford County. Sec. 6 Twp 22 Rge. 12 (E) (W)

Location as "NE/CNW/SW" or footage from lines SE NE NW
Lease Owner H.C. Bennett
Lease Name Elsen Well No. 1
Office Address 1212 Union Nat'l Bldg. Wichita, Kansas
Character of Well (completed as Oil, Gas or Dry Hole) Oil well
Date well completed 3-19-63 19
Application for plugging filed 8-30-66 19
Application for plugging approved 8-31-66 19
Plugging commenced 9-2-66 19
Plugging completed 9-3-66 19
Reason for abandonment of well or producing formation depleted

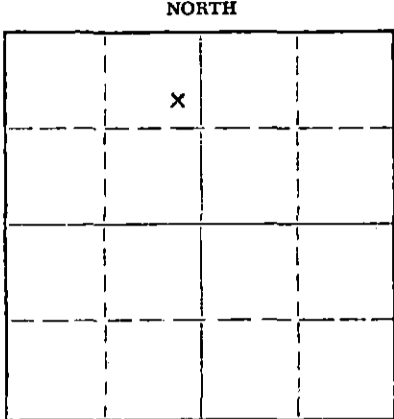

Locate well correctly on above Section Plat

If a producing well is abandoned, date of last production 19
Was permission obtained from the Conservation Division or its agents before plugging was commenced? yes

Name of Conservation Agent who supervised plugging of this well Archie Elving & Herman Justice
Producing formation _____ Depth to top _____ Bottom _____ Total Depth of Well 3655 Feet
Show depth and thickness of all water, oil and gas formations.

OIL, GAS OR WATER RECORDS

CASING RECORD

FORMATION	CONTENT	FROM	TO	SIZE	PUT IN	PULLED OUT
				8 5/8	346'	none
				5 1/2	3655'	3000'

Describe in detail the manner in which the well was plugged, indicating where the mud fluid was placed and the method or methods used in introducing it into the hole. If cement or other plugs were used, state the character of same and depth placed, from _____ feet to _____ feet for each plug set.

Fill hole with sand from 3655' to 3400' and dump 5 sacks of cement

Set 15' rock bridge from 300' to 285' and dump 25 sacks of cement

Mud hole to 40', rock to 30' and dump 10 sacks of cement to surface

RECEIVED
STATE CORPORATION COMMISSION

SEP 14 1966

CONSERVATION DIVISION
Wichita, Kansas

(If additional description is necessary, use BACK of this sheet)
Name of Plugging Contractor Flint Engineering and Const. Co.
Address 2375 W. Central El Dorado, Kansas

STATE OF Kansas, COUNTY OF Butler, ss.

(employee of owner) or (owner or operator) of the above-described well, being first duly sworn on oath, says: That I have knowledge of the facts, statements, and matters herein contained and the log of the above-described well as filed and that the same are true and correct. So help me God.

(Signature) *Ronald R. Hanson*

SUBSCRIBED AND SWORN TO before me this 13 day of Sept., 19 66

Ronald R. Hanson

Notary Public.

My commission expires Sept. 27, 1967


WELL LOG BUREAU—KANSAS GEOLOGICAL SOCIETY
508 East Murdock, Wichita, Kansas

Company- JOHN C. GRAVES & PET. INC.
Farm- Elsen No. 1

SEC. 6 T. 22 R. 12W
SE NE NW

Total Depth. 3655'
Comm. 3-12-63 Comp. 3-19-63
Shot or Treated.
Contractor. Graves Drilling Co., Inc.
Issued. 8-3-63

County Stafford
KANSAS

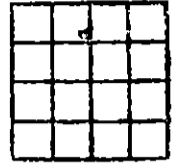

CASING:

8 5/8" 346.92' cem w/250 sx.
5 1/2" 2657' cem w/100 sx.

Elevation. 1872' KB

Production. 25 BOPD

Figures Indicate Bottom of Formations.

sand & shale	193
shale & sand	318
red bed	344
redbed & shale	730
shale & lime strks.	1710
lime & shale	2270
shale & lime	2810
lime	3010
shale & lime	3285
lime	3582
lime & shale	3627
lime	3655 RTD
Total Depth	

RECEIVED
STATE CORPORATION COMMISSION

SEP 14 1966

CONSERVATION DIVISION
Wichita, Kansas

TOPS: LOG

Anhydrite	675
Topeka	2866
Queens Hill	3051
Heebner	3154
Toronto	3172
Douglas	3187
Brown Lime	3285
Lansing	3302
Base Kansas City	3523
Viola	3556
Simpson	3595
Arbuckle	3652