


WELL PLUGGING RECORD

Give All Information Completely
Make Required Affidavit
Mail or Deliver Report to:
Conservation Division
State Corporation Commission
212 North Market, Insurance Bldg.
Wichita, Kansas

Stafford County, Sec. 6 Twp. 22 Rge. 12 (E) (W)

Location as "NE/CNW/SW" or footage from lines SW NW NE
Lease Owner R. P. Nixon Operations, Inc.
Lease Name Blackburn Well No. 1
Office Address 754 East Wichita Avenue, Russell, Kansas
Character of Well (completed as Oil, Gas or Dry Hole) Dry Hole
Date well completed Nov. 10, 1964
Application for plugging filed Nov. 10 1964
Application for plugging approved Nov. 13 1964
Plugging commenced Nov. 10 1964
Plugging completed Nov. 10 1964
Reason for abandonment of well or producing formation Dry Hole

NORTH

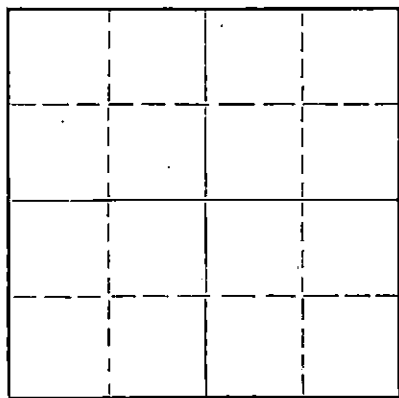

Locate well correctly on above
Section Plat

If a producing well is abandoned, date of last production 19
Was permission obtained from the Conservation Division or its agents before plugging was commenced? yes

Name of Conservation Agent who supervised plugging of this well A. Elving
Producing formation _____ Depth to top _____ Bottom _____ Total Depth of Well 3665 Feet
Show depth and thickness of all water, oil and gas formations.

OIL, GAS OR WATER RECORDS

CASING RECORD

FORMATION	CONTENT	FROM	TO	SIZE	PUT IN	PULLED OUT
			245'	8 5/8"	cmtd w/250	sax

Describe in detail the manner in which the well was plugged, indicating where the mud fluid was placed and the method or methods used in introducing it into the hole. If cement or other plugs were used, state the character of same and depth placed, from _____ feet to _____ feet for each plug set.

1st plug @ 235' Cemented w/25 sacks
2nd plug @ 40'. Cemented w/98 sacks

RECEIVED
STATE CORPORATION COMMISSION

DEC 31 1964

12-31-64

CONSERVATION DIVISION
Wichita, Kansas

(If additional description is necessary, use BACK of this sheet)
Name of Plugging Contractor Shields Drilling Company, Inc.
Address Russell, Kansas

STATE OF KANSAS COUNTY OF RUSSELL, ss.
R. P. Nixon (employee of owner) or (owner or operator) of the above-described

well, being first duly sworn on oath, says: That I have knowledge of the facts, statements, and matters herein contained and the log of the above-described well as filed and that the same are true and correct. So help me God.

(Signature) R. P. Nixon

754 East Wichita Avenue, Russell, Kansas
(Address)

SUBSCRIBED AND SWORN to before me this 12th day of November, 19 64

Ruth E. Miller
Notary Public.

My commission expires January 5, 1969



Shields


15-185-19411-0000

Russell, Kansas

WELL LOG

Operator: R. P. Nixon
 Well: Blackburn #1
 Commenced: November 3, 1964
 Completed: November 10, 1964
 Contractor: Shields Drilling Co., Inc.

Well Description: SW NW NE
 Sec. 6-22S-12W
 Stafford County, Kansas

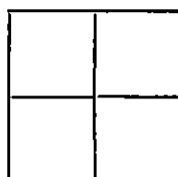

CASING RECORD

Size	Run	Pulled
8 5/8"	245'	Cmtd w/ 250 sax

Elevation: 1873' RB

Treatment:

Production: D & A

Tops:

Heebner	3,159'
Toronto	3,178'
Lansing-KC	3,306'
Viola	3,562'
Simpson	3,602'
Arbuckle	3,658'

..... Figures Indicate Bottom of Formations

Surface soil, shale & shells	245'
Shale, shells & redbed	677'
Anhydrite	710'
Redbed & shale	974'
Shale, shells, salt & lime	1,630'
Lime	2,175'
Shale & lime streaks	2,865'
Lime & shale	3,107'
Lime	3,515'
Lime & chert	3,660'
Lime	3,665' RTD

RECEIVED
 STATE CORPORATION COMMISSION
 DEC 31 1964
 CONSERVATION DIVISION
 Wichita, Kansas

NOTES

DST #1	3,422' - 3,441'	Tool open 30 min. w/ weak blow for 11 min. Recovered 10' mud. All pressures 0 #
DST #2	3,441' - 3,481'	Tool open 1 hr. Recovered 300' muddy water. IBHP-1050 #, IFP-150 #, FFP-40 #, FBHP-920#
DST #3	3,652' - 3,661'	Tool open 1 hr. Recovered 480' gas cut water. IBHP-950 #, IFP-170#, FFP-200 #, FBHP-945#