


STATE OF KANSAS
STATE CORPORATION COMMISSION

WELL PLUGGING RECORD.

Give All Information Completely
Make Required Affidavit
Mail or Deliver Report to:
Conservation Division
State Corporation Commission
800 Bittling Building
Wichita, Kansas

Stafford County, Sec. 6 Twp. 22 Rge. (E) 12 (W)
Location as "NE/CNW $\frac{1}{4}$ SW $\frac{1}{4}$ " or footage from lines SW $\frac{1}{4}$ SW $\frac{1}{4}$ NW $\frac{1}{4}$ (ing Co.)
Lease Owner Crown Oil Co., Inc. & Harms and Knight Drill-/
Lease Name Elsen Well No. 1
Office Address Box 184, Great Bend, Kansas
Character of Well (completed as Oil, Gas or Dry Hole) Dry Hole
Date well completed 7-18 19 49
Application for plugging filed 7-19 19 49
Application for plugging approved 7-19 19 49
Plugging commenced 7-19 19 49
Plugging completed 7-19 19 49
Reason for abandonment of well or producing formation

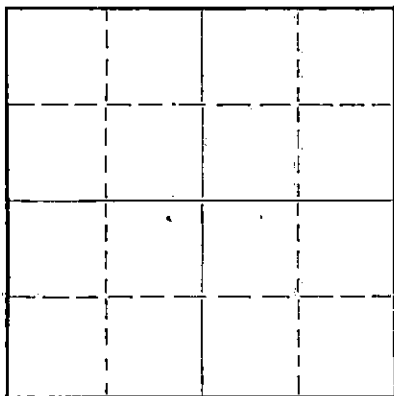

If a producing well is abandoned, date of last production 19
Was permission obtained from the Conservation Division or its agents before plugging was commenced? Yes

Name of Conservation Agent who supervised plugging of this well C. D. Stough
Producing formation Depth to top Bottom Total Depth of Well Feet
Show depth and thickness of all water, oil and gas formations.

OIL, GAS OR WATER RECORDS

CASING RECORD

Formation	Content	From	To	Size	Put In	Pulled Out
				8 5/8"	7-8-49	

Describe in detail the manner in which the well was plugged, indicating where the mud fluid was placed and the method or methods used in introducing it into the hole. If cement or other plugs were used, state the character of same and depth placed, from feet to feet for each plug set.

Filled hole w/heavy mud; set plug @ 240';
cemented w/15 sax cement; filled to 45'
w/heavy mud; set plug and cemented w/10
sax bulk cement.

RECEIVED
CONSTRUCTION
AUG 2 - 1949 8-2-49
STATE CORPORATION
COMMISSION
WICHITA

(If additional description is necessary, use BACK of this sheet)

Correspondence regarding this well should be addressed to Harms & Knight Drilling Company,
Address Box 184, Great Bend, Kans.

STATE OF Kansas, COUNTY OF Barton, ss.
H. A. Harms (employee of owner) or (owner or operator) of the above-described well,
being first duly sworn on oath, says: That I have knowledge of the facts, statements, and matters herein contained and the log of the above-described well as filed and that the same are true and correct. So help me God.

(Signature) H. A. Harms
Box 184, Great Bend, Kans.
(Address)

SUBSCRIBED AND SWORN to before me this 29 day of July, 1949
Notary Public

My commission expires 10-15-51

PLUGGING
FILE SEC 6 T22 R12W
BOOK PAGE 106 LINE 30

WELL LOG

Crown Oil Company, Inc., &
Harms & Knight Drilling Co.
ELSEN #1

Sec. 6; T-22S; R-12W
SW/4 SW/4 NW/4
County: Stafford

Total Depth 3701'
Comm: 7-8-49 Comp: 7-18-49
Contractor: Harms & Knight Drlg. Co.
Issued 7-29-49 Rotary 0-3701'

Elevation:
Production: Dry

Casing Record: 8 5/8" Set @ 253' Cemented
with 200 sax cement, circulated.

Figures Indicate Bottom of Formations:

Cellar	5
sand & clay	190
shells & red bed	253
red bed	665
anhydrite	695
red bed & shale	1510
shale & shells	
shale & shells	1680
lime	1795
lime & shale	2330
shale & shells	2830
lime & shale	3610
lime & chert	3701
Total Depth	3701

We hereby certify this to be a correct and accurate log
of the above described well as shown on the daily drilling
reports.

HARMS & KNIGHT DRILLING COMPANY

By: *W. H. Harms*

Subscribed and sworn to before me this 29th day of July, 1949.

My Commission Expires:

Oct. 15, 1951

W. H. Harms
Notary Public

