


STATE OF KANSAS
STATE CORPORATION COMMISSION

Form CP-4

Give All Information Completely
Make Required Affidavit
Mail or Deliver Report to:
Conservation Division
State Corporation Commission
212 No. Market
Wichita, Kansas

WELL PLUGGING RECORD

NORTH

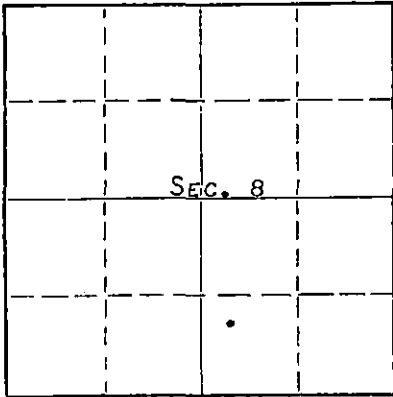

Locate well correctly on above
Section Plat

STAFFORD County. Sec. 8 Twp. 22s Rge. 14 (E) (W)
Location as "NE/CNW/SW" or footage from lines NW SW SE
Lease Owner PETROLEUM, INC.,
Lease Name UNRUH Well No. 3
Office Address R. R. #2, GREAT BEND, KANSAS
Character of Well (completed as Oil, Gas or Dry Hole) DRY HOLE
Date well completed AUGUST 3 19 67
Application for plugging filed AUGUST 3 19 67
Application for plugging approved AUGUST 3 19 67
Plugging commenced AUGUST 3 19 67
Plugging completed AUGUST 3 19 67
Reason for abandonment of well or producing formation NO PRODUCIBLE ZONE

If a producing well is abandoned, date of last production NONE 19
Was permission obtained from the Conservation Division or its agents before plugging was commenced? YES

Name of Conservation Agent who supervised plugging of this well ARCHIE ELVING
Producing formation _____ Depth to top _____ Bottom _____ Total Depth of Well 3925' Feet
Show depth and thickness of all water, oil and gas formations.

OIL, GAS OR WATER RECORDS

CASING RECORD

FORMATION	CONTENT	FROM	TO	SIZE	PUT IN	PULLED OUT
				8-5/8"	292'	NONE

Describe in detail the manner in which the well was plugged, indicating where the mud fluid was placed and the method or methods used in introducing it into the hole. If cement or other plugs were used, state the character of same and depth placed, from _____ feet to _____ feet for each plug set.

MUD TO 400', WOODEN PLUG, 50 SACKS CEMENT THRU DRILL PIPE. MUD TO 40'.
WOODEN PLUG, 1/2 SACK HULLS, 10 SACKS CEMENT TO BASE OF WELL CELLAR.

RECEIVED
STATE CORPORATION COMMISSION

AUG 15 1967

CONSERVATION DIVISION
Wichita, Kansas

8-15-67

(If additional description is necessary, use BACK of this sheet)

Name of Plugging Contractor GARVEY DRILLING CO.
Address R. R. #2, GREAT BEND, KANSAS

STATE OF KANSAS, COUNTY OF BARTON, ss.
LAWRENCE PROFFITT (employee of owner) or (owner or operator) of the above-described

well, being first duly sworn on oath, says: That I have knowledge of the facts, statements, and matters herein contained and the log of the above-described well as filed and that the same are true and correct. So help me God. LAWRENCE PROFFITT, DIST. PROD. FOREMAN

(Signature) Lawrence Proffitt
R. R. #2, GREAT BEND, KANSAS
(Address)

SUBSCRIBED AND SWORN TO before me this 14 day of AUGUST, 19 67

Richard H. Dumble
Notary Public.

My commission expires MAY 28, 1969

WELL LOG

COMPANY Petroleum, Inc.

SEC. 8 T. 22S R. 14W

FARM Unruh

NO. 3

LOC. NW SW SE

TOTAL DEPTH 3925'

COUNTY Stafford

COMM. 7-24-67

COMP. 8-3-67

CONTRACTOR Garvey Drilling Company

CASING 8 5/8" @ 292' w/250 sx

ELEVATION 1958' KB

PRODUCTION D & A

FIGURES INDICATE BOTTOM OF FORMATIONS

- 90' Sand
- 292' Shale and Sand Streaks
- 970' Red Bed, Anhydrite and Shale
- 1595' Shale and Shells
- 1750' Shale
- 2018' Lime and Shale
- 2175' Lime
- 2235' Shale and Lime
- 2456' Lime and Shale
- 2815' Shale and Lime
- 3085' Lime and Shale
- 3245' Lime
- 3475' Lime and Shale
- 3567' Lime
- 3612' Lime and Shale
- 3690' Lime
- 3775' Lime and Shale
- 3870' Lime, Shale, and Chert Sand
- 3925' Lime and Shale
- 3925' RTD

RECEIVED
STATE OIL AND GAS COMMISSION

AUG 15 1967

CONSERVATION DIVISION
WICHITA, KANSAS

State of Kansas }
County of Barton } ss

I, Sam N. Stephens of Garvey Drilling Company

upon oath state the above and foregoing is a true and correct copy of the log of the Unruh No. 3 well.

Sam N. Stephens

Subscribed and sworn to before me this 12th day of August 1967

My Commission Expires: November 5th, 1969

Richard L. Doy
NOTARY PUBLIC