


STATE OF KANSAS  
STATE CORPORATION COMMISSION

Form CP-4

WELL PLUGGING RECORD

Give All Information Completely  
Make Required Affidavit  
Mail or Deliver Report to:  
Conservation Division  
State Corporation Commission  
P. O. Box 17027  
Wichita, Kansas 67217  
NORTH

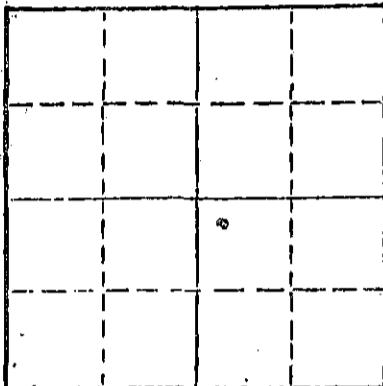

Locate well correctly on above  
Section Plot

Stafford County, Sec. 8 Twp. 22 Rge. (E) 14 (W)  
Location as "NE/CNW/SW" or footage from lines. NW NW SE  
Lease Owner Petroleum, Inc.  
Lease Name Unruh Well No. 2  
Office Address Route 2, Great Bend, Kansas 67530  
Character of Well (completed as Oil, Gas or Dry Hole) oil  
Date well completed 10  
Application for plugging filed 10  
Application for plugging approved 10  
Plugging commenced March 1 10 74  
Plugging completed March 14 19 74  
Reason for abandonment of well or producing formation depleted  
If a producing well is abandoned, date of last production 10

Was permission obtained from the Conservation Division or its agents before plugging was commenced? yes

Name of Conservation Agent who supervised plugging of this well G. R. Biberstein  
Producing formation Depth to top Bottom Total Depth of Well 3925 Feet  
Show depth and thickness of all water, oil and gas formations.

OIL, GAS OR WATER RECORDS

CASING RECORD

FORMATION	CONTENT	FROM	TO	SIZE	PUT IN	PULLED OUT
		0	255'	8 5/8"	255'	none
			3923'	5 1/2"	3923'	2931.92

Describe in detail the manner in which the well was plugged, indicating where the mud fluid was placed and the method or methods used in introducing it into the hole. If cement or other plugs were used, state the character of same and depth placed, from feet to feet for each plug set.

Sanded back to 3810' and dumped 5 sacks of cement.

Sun Cementing Company plugged well pumping in 2 sacks of hulls, 10 sacks of gel and 100 sacks of cement.

RECEIVED  
STATE CORPORATION COMMISSION  
MAR 20 1974  
CONSERVATION DIVISION  
Wichita, Kansas

(If additional description is necessary, use BACK of this sheet)  
Name of Plugging Contractor PIPE PULLERS, INC.  
Address Box 486, Ellinwood, Kansas 67526

STATE OF KANSAS COUNTY OF BARTON, ss.  
Evelyn Roth (employee of owner) or (owner or operator) of the above-described well, being first duly sworn on oath, says: That I have knowledge of the facts, statements, and matters herein contained and the log of the above-described well as filed and that the same are true and correct. So help me God.

(Signature) Evelyn Roth  
Ellinwood, Kansas  
(Address)

SUBSCRIBED AND SWORN TO before me this 19th day of March, 1974

My commission expires Feb. 10, 1975

Serge A Meyer  
Notary Public.

# WELL LOG

15-185.13164-0000

COMPANY PETROLEUM, INCORPORATED

SEC. 8 T. 22S R. 14W

FARM UNRUH

NO. 2

LOC. NW, NW, SE


TOTAL DEPTH 3925'

COUNTY STAFFORD CO., KANSAS

COMM. July 12, 1958

COMP. July 22, 1958

CONTRACTOR GARVEY DRILLING COMPANY

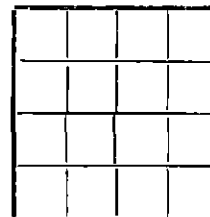

CASING 8 5/8" @ 254' W/150 sax,  
5 1/2" @ 3923' W/75 sax.

ELEVATION 1956' DF

PRODUCTION SIMPSON

FIGURES INDICATE BOTTOM OF FORMATIONS

120	Sand
255	Sand & clay
490	Sand & red bed
875	Red bed & shale
905	Anhydrite
1220	Shale & shells
1650	Shale, shells & lime
2400	Lime & shale
2585	Shale & lime
2900	Lime & shale
3030	Shale & lime
3135	Lime & shale
3334	Lime
3414	Lime & shale
3775	Lime
3810	Cherty lime
3823	Chert
3895	Lime & shale
3925	Arbuckle lime.
3925	T. D.

RECEIVED  
STATE CORPORATION COMMISSION  
MAR 22 1974  
CONSERVATION DIVISION  
Wichita, Kansas

State of KANSAS }  
County of BARTON } ss:

I, VERNE A. MORRIS of GARVEY DRILLING CO.

upon oath state that the above and foregoing is a true and correct copy of the log of the #2 UNRUH well

Subscribed and sworn to before me this 30th day of September 1958

My Commission Expires: July 11, 1960

Verne A. Morris  
John T. Brown  
NOTARY PUBLIC