


STATE OF KANSAS
STATE CORPORATION COMMISSION

Form CP-4

Give All Information Completely
Make Required Affidavit
Mail or Deliver Report to:
Conservation Division
State Corporation Commission
212 No. Market
Wichita, Kansas

WELL PLUGGING RECORD

NORTH

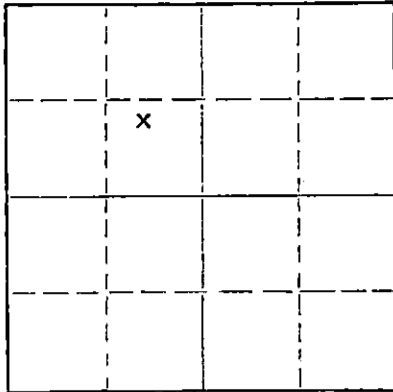

Locate well correctly on above
Section Plat

Stafford County, Sec. 10 Twp. 22 Rge. 12 (X) (W)
Location as "NE/CNW%SW%" or footage from lines CN/2-SE NW
Lease Owner H.C. Bennett
Lease Name Spangenberg Well No. 2
Office Address 1212 Union Nat'l Bldg. Wichita, Ks.
Character of Well (completed as Oil, Gas or Dry Hole) Oil Well
Date well completed 8-10-49 19__
Application for plugging filed 12-19-66 19__
Application for plugging approved 12-20-66 19__
Plugging commenced 12-26-66 19__
Plugging completed 1-2-67 19__
Reason for abandonment of well or producing formation depleted

If a producing well is abandoned, date of last production _____ 19__
Was permission obtained from the Conservation Division or its agents before plugging was commenced? yes

Name of Conservation Agent who supervised plugging of this well Archie Elving
Producing formation _____ Depth to top _____ Bottom _____ Total Depth of Well 3665 Feet
Show depth and thickness of all water, oil and gas formations.

OIL, GAS OR WATER RECORDS				CASING RECORD		
FORMATION	CONTENT	FROM	TO	SIZE	PUT IN	PULLED OUT
				8 5/8	212	none
				5 1/2	3662'	2755'

Describe in detail the manner in which the well was plugged, indicating where the mud fluid was placed and the method or methods used in introducing it into the hole. If cement or other plugs were used, state the character of same and depth placed, from _____ feet to _____ feet for each plug set.

Fill hole with chat from 3665' to 3650' and dump 5 sacks of cement
Set 10' rock bridge from 215' to 205' and mix and dump 5 sacks of cement
Left Cement set over night
Bail hole dry to bridge and dump 20 sacks of cement
Mud hole to 40', rock to 30' and dump 10 sacks of cement

1-2-67

Stamp: STATE CORPORATION COMMISSION
JAN 12 1967
CONSERVATION DIVISION
WICHITA, KANSAS

(If additional description is necessary, use BACK of this sheet)
Name of Plugging Contractor Flint Engineering and Const. Co.
Address 2375 W. Central El Dorado, Kansas

STATE OF Kansas, COUNTY OF Butler, ss.

_____, (employee of owner) or (owner or operator) of the above-described well, being first duly sworn on oath, says: That I have knowledge of the facts, statements, and matters herein contained and the log of the above-described well as filed and that the same are true and correct. So help me God.

(Signature) James Davis

SUBSCRIBED AND SWORN TO before me this 11 day of January, 19 66

My commission expires Sept. 27, 1967
Ronald R. Hanson Notary Public.

COPY


WELL LOG BUREAU--KANSAS GEOLOGICAL SOCIETY
508 East Murdock, Wichita, Kansas.

Company - PETROLEUM, INC.
Farm - Spangenberg No. 2

SEC. 10 T. 22 R. 12N
CN/2 SE NW

Total Depth. 3665
Comm. 7-28-49 Comp. 8-10-49
Shot or Traced.
Contractor. Drillers, Inc.
Issued. 10-15-49

County. Stafford
KANSAS

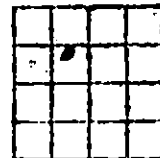

Elevation. _____

Production. Phys. 40 bbls.

CASING:
8 5/8" 212' - 150 lbs Cement
5 1/2" 3662' - 110 lbs Cement

Figures Indicate Bottom of Formations.

sand	150
shale, shells	280
shale, red bed	635
anhydrite	670
shale, red bed	1070
shale	1430
shale, shells	1520
lime	1980
lime, shale	2085
lime	2185
lime, shale	2930
lime	3546
Viola (chert)	3595
chert	3602
lime, shale	3665
Total depth	

Tops:	
Anhydrite	670
Heebner	3146
Toronto	3167
Brown lime	3280
Lansing	3300
Viola	3554
Simpson	3602
Arbuckle	3661

open Hole

RECEIVED
STATE CORPORATION COMMISSION

JAN 12 1967

CONSERVATION DIVISION
Wichita, Kansas

Cement Log Top 2700'