


WELL PLUGGING RECORD

Give All Information Completely
Make Required Affidavit
Mail or Deliver Report to:
Conservation Division
State Corporation Commission
800 Biting Building
Wichita, Kansas

Stafford County. Sec. 10 Twp. 22 Rge. 12 ~~W~~ W (W)
Location as "NE/CNW/SW" or footage from lines NW-SW-NW
Lease Owner Petroleum, Incorporated
Lease Name Spangenberg Well No. 3
Office Address 311 East Third, Wichita, Kansas
Character of Well (completed as Oil, Gas or Dry Hole) Oil
Date well completed August 30, 19 49
Application for plugging filed September 26, 19 55
Application for plugging approved September 28, 19 55
Plugging commenced October 24, 19 55
Plugging completed October 26, 19 55
Reason for abandonment of well or producing formation Depletion Of
Producing Zones

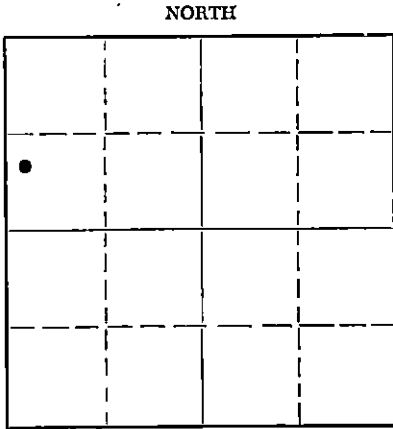

Locate well correctly on above Section Plat

If a producing well is abandoned, date of last production October 1, 19 55
Was permission obtained from the Conservation Division or its agents before plugging was commenced? Yes
Name of Conservation Agent who supervised plugging of this well W.H. Horner Box 207, Great Bend, Kansas
Producing formation Kansas City Depth to top 3,302' Bottom 3,524' Total Depth of Well 3,668.5' Feet
Show depth and thickness of all water, oil and gas formations.

OIL, GAS OR WATER RECORDS

CASING RECORD

FORMATION	CONTENT	FROM	TO	SIZE	PUT IN	PULLED OUT
Arbuckle (open hole)	Oil & water	3,665'	3,668.5'	8 5/8" OD	200'	None
Kansas City	Oil & water	3,343'	3,347'	5 1/2" OD	3,664'	3,000'

Describe in detail the manner in which the well was plugged, indicating where the mud fluid was placed and the method or methods used in introducing it into the hole. If cement or other plugs were used, state the character of same and depth placed, from _____ feet to _____ feet for each plug set.

(Plugged back to 3,404')

Filled hole with crushed rock from 3,404' to 3,530', and placed 5 sacks of cement on top of rock. Mudded up to 200', and placed solid rock bridge on top of mud. Placed 20 sacks of cement on to rock bridge & mudded up to 35'. Made solid rock bridge at 35', and filled hole to base of well cellar with 10 sacks cement.

10-29-55

FILED

NOV 1 1955

(If additional description is necessary, use BACK of this sheet)
Name of Plugging Contractor Morgan Well Plugging Service
Address 102 West 18th, Hutchinson, Kansas

STATE OF Kansas, COUNTY OF Barton, ss.
C.J. Wiltse (employee of owner) or (owner or operator) of the above-described well, being first duly sworn on oath, says: That I have knowledge of the facts, statements, and matters herein contained and the log of the above-described well as filed and that the same are true and correct. So help me God.

(Signature)

C.J. Wiltse

Route 2, Great Bend, Kansas
(Address)

SUBSCRIBED AND SWORN to before me this 27th day of October, 1955

Ray E. Anderson
Notary Public.

My commission expires November 21, 1957

PLUGGING
FILED SEC. 10 T. 22 R. 12 W
BOOK PAGE 4 LINE 8

WELL LOG SPANGENBERG NO. 3

Petroleum, Inc., Lease Owner.

Section 10, Twp. 22S, R. 12W

Drillers, Inc., Contractor

Location: NW SW NE

Rotary Total Depth: 3665

County: Stafford, Kansas

Commenced: August 11, 1949

Production:

Completed: August 22, 1949

Elevation: 1862 D.F.

Casing: 209.86' of 8 5/8"
3676.50' of 5 1/2"

Figures below indicate bottom of formation:

150	Sand	3282	Shale
197	Shale & Shells	3520	Lime
200	Lime Shell	3553	Lime & Shale
215	Shale & Shells	3607	Viola (Chert)
235	Red Bed	3625	Shale
645	Shale & Red Bed	3662	Lime & Shale
685	Anhydrite	3665	Lime
810	Shale & Red Bed		
1070	Shale & Shells	3665	R.T.D.
1210	Shale & Salt		
1440	Shale & Shells		
1530	Lime & Shale		
2205	Lime		
2380	Shale & Lime		
2500	Shale		
2855	Shale & Lime		
3215	Lime		

Tops

645	Anhydrite
3150	Heebner
3170	Toronto
3184	B.O.
3282	Br. Lime
3302	Lansing - 240
3524	B.K.C.
3555	P.B.C.
3560	Viola
3607	Simpson
3664	Arbuckle

I hereby certify that this is a true and correct log of the above mentioned well.

PETROLEUM, INC.

Eric H. Jager

Eric H. Jager

STATE OF KANSAS
SEDGWICK COUNTY

PLUGGING
SEE SEC. 10, T. 22S, R. 12W
SS. BOOK PAGE 4 LINE 2

RECEIVED
STATE CORPORATION COMMISSION

Subscribed to and sworn to before me, a Notary Public in said County and State this 30th day of August, 1949.

OCT 29 1955

CONSERVATION DIVISION
Wichita, Kansas

Raymond Fitch
Notary Public

My commission expires: June 7, 1952.