

Give All Information Completely
Make Required Affidavit
Mail or Deliver Report to:
Conservation Division
State Corporation Commission
212 No. Market
Wichita, Kansas

WELL PLUGGING RECORD

Stafford County, Sec. 10 Twp. 22 Rge. 12 (E) (W)

Location as "NE/CNW/SW" or footage from lines. CWL-SE NW

Lease Owner H.C. Bennett

Lease Name Spangenberg Well No. 6

Office Address 1212 Union Nat'l Bldg. Wichita, Kansas

Character of Well (completed as Oil, Gas or Dry Hole) oil well

Date well completed 11-5-49 19

Application for plugging filed 12-19-66 19

Application for plugging approved 12-20-66 19


Plugging commenced 1-2-67 19

Plugging completed 1-5-67 19

Reason for abandonment of well or producing formation depleted

If a producing well is abandoned, date of last production 19

Was permission obtained from the Conservation Division or its agents before plugging was commenced? yes

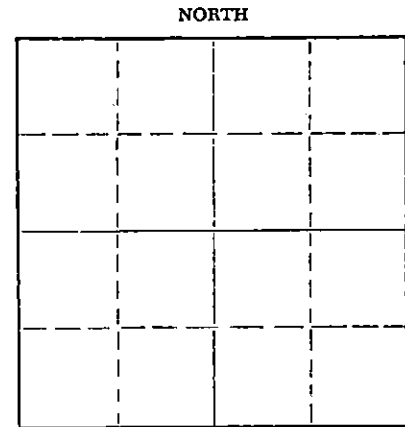

Locate well correctly on above Section Plot

Name of Conservation Agent who supervised plugging of this well Archie Elving

Producing formation _____ Depth to top _____ Bottom _____ Total Depth of Well 3663 Feet

Show depth and thickness of all water, oil and gas formations.

OIL, GAS OR WATER RECORDS

CASING RECORD

FORMATION	CONTENT	FROM	TO	SIZE	PUT IN	PULLED OUT
				8 5/8	219'	none
				5 1/2	3663'	2590'

Describe in detail the manner in which the well was plugged, indicating where the mud fluid was placed and the method or methods used in introducing it into the hole. If cement or other plugs were used, state the character of same and depth placed, from _____ feet to _____ feet for each plug set.

Set 15' chat bridge from 3200' to 3185' and dump 5 sacks of cement


Set 10' rock bridge from 210' to 200' and mix and dump 5 sacks of cement

Let set over night

Bail hole dry to bridge and dump 20 sacks of cement

Mud hole to 40', rock to 30', and dump 10 sacks of cement

1-12-67

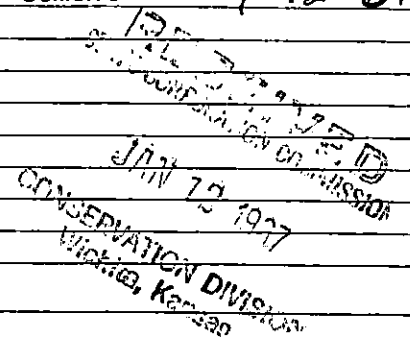

Name of Plugging Contractor Flint Engineering and Const. Co.
Address 2375 W. Central El Dorado, Kansas

STATE OF Kansas COUNTY OF Butler, ss.

(employee of owner) or (owner or operator) of the above-described well, being first duly sworn on oath, says: That I have knowledge of the facts, statements, and matters herein contained and the log of the above-described well as filed and that the same are true and correct. So help me God.

(Signature) *Jesse Davis*

(Address)

SUBSCRIBED AND SWORN TO before me this 11 day of January, 19 67

Sept. 27, 1967

Ronald R. Hanson

Notary Public.

My commission expires _____

WELL LOG BUREAU KANSAS GEOLOGICAL SOCIETY
508 East Murdock, Wichita, Kansas

Company - PETROLEUM, INC.
Farm - Spangenberg No. 6

SEC. 10 T. 22 R. 12W
CWL SE NW

Total Depth. 3663
Comm. 10-22-49 Comp. 11-5-49
Shot or Treated.
Contractor. Drillers, Inc.
Issued. 1-7-50

County. Stafford
KANSAS



Elevation. _____

Production. Phys. 87 bbls.

CASING:
8 5/8" 219' - 150 lbs -
5 1/2" 3663.67' - 110 lbs -

Figures Indicate Bottom of Formations.

sand	145
shale	180
lime shells	197
shale, shells	205
red bed	655
anhydrite	675
shale, shells	930
shale	1185
lime, shale	1500
lime	1935
lime, shale	2420
lime	3140
shale	3220
lime, shale	3300
lime	3339
lime, shale	3555
Viola (chert)	3574
chert	3600
shale	3659
Arbuckle	3663 — T.D.
Total Depth	

Cement Top ?

Tops:	
Anhydrite	655
Heebner	3147
Toronto	3167
Base Oread	3182
Brown Lime	3280
Lansing	3300
Base Kansas City	3523
P. B. C.	3550
Viola	3554
Simpson	3600
Arbuckle	3663

Top perf. @ 3226'

RECEIVED
STATE CORPORATION COMMISSION
JAN 12 1967
CONSERVATION DIVISION
Wichita, Kansas