


STATE OF KANSAS
STATE CORPORATION COMMISSION

WELL PLUGGING RECORD

Give All Information Completely
Make Required Affidavit
Mail or Deliver Report to:
Conservation Division
State Corporation Commission
211 No. Broadway
Wichita, Kansas

Stafford County. Sec. 11 Twp. 22S Rge. (E) 12 (W)
Location as "NE/CNW/SW" or footage from lines SE/4 SW/4 SW/4
Lease Owner L. E. Phillips, Jr.
Lease Name Voigt "B" Well No. 1
Office Address 1407 Union National Bldg., Wichita 2, Kansas
Character of Well (completed as Oil, Gas or Dry Hole) Dry Hole
Date well completed June 21 19 57
Application for plugging filed (Verbally approved) June 24 19 57
Application for plugging approved (Verbally approved) 19
Plugging commenced June 21 19 57
Plugging completed June 21 19 57
Reason for abandonment of well or producing formation

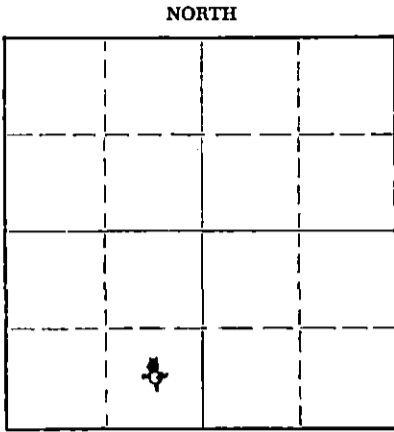

Locate well correctly on above
Section Plat

If a producing well is abandoned, date of last production 19
Was permission obtained from the Conservation Division or its agents before plugging was commenced? Yes

Name of Conservation Agent who supervised plugging of this well R. M. Brundege
Producing formation Arbuckle Depth to top Bottom Total Depth of Well 3687 Feet
Show depth and thickness of all water, oil and gas formations.

OIL, GAS OR WATER RECORDS

CASING RECORD

FORMATION	CONTENT	FROM	TO	SIZE	PUT IN	PULLED OUT
		0	210'	8-5/8"	214.50'	None

Describe in detail the manner in which the well was plugged, indicating where the mud fluid was placed and the method or methods used in introducing it into the hole. If cement or other plugs were used, state the character of same and depth placed, from feet to feet for each plug set.

Plugged Hole 20 sacks cement mixed and poured thru drill pipe on 1/3 sack hulls and bottom plug set at 190'; hole filled with mud to 25' ground surface. 5 sacks cement mixed and poured on top plug set at 25'. Completed plugging hole at 4:30 A.M. 6/21/57

(If additional description is necessary, use BACK of this sheet)
Name of Plugging Contractor Birmingham-Bartlett Drilling Co.
Address 300 Kaufman Building, Wichita 2, Kansas

STATE OF KANSAS COUNTY OF SEDGWICK ss.
Richard Hindery, partner of Birmingham-Bartlett Drilling Co., contractor,
(employee of owner) or (owner or operator) of the above-described well, being first duly sworn on oath, says: That I have knowledge of the facts, statements, and matters herein contained and the log of the above-described well as filed and that the same are true and correct. So help me God. BIRMINGHAM-BARTLETT DRILLING CO.
(Signature) By Richard Hindery
300 Kaufman Building
Wichita 2, Kansas
(Address)

SUBSCRIBED AND SWORN TO before me this 24th day of June, 19 57.
Vivian J. Yinger
Notary Public.

My commission expires November 29, 1958.

RECEIVED
STATE CORPORATION COMMISSION
7-17-57

JUL 17 1957

CONSERVATION DIVISION
Wichita, Kansas

PLUGGING
FILE SEC 11 T 22 R 12W
BOOK PAGE 22 LINE 35

VOIGT "B" #1 WELL

LOCATION: SE/4 SW/4 SW/4 Sec. 11-22S-12W
Stafford County, Kansas

SPUDED: June 12, 1957

COMPLETED: June 21, 1957

OWNER & OPERATOR: L. E. Phillips, Jr.
1407 Union National Building
Wichita 2, Kansas

CONTRACTOR: Birmingham-Bartlett Drilling Co.
300 Kaufman Building
Wichita 2, Kansas

SURFACE CASING: 214.50' 8-5/8" surface casing
cemented at 210' with 200 sacks
cement and 2 c.c.

OIL SPRING: None set. - Dry, Plugged & Abandoned

LOG

(Figures indicate bottom of formation)

0 -	25	Clay
	150	Sand
	180	Shale
	642	Red Bed
	665	Anhydrite
	1410	Shale & Shells
	1530	Shale & Lime
	1680	Brown Lime & Shale
	2035	Lime & Shale
	2210	Brown Lime & Shale
	2680	Lime & Shale
	2760	Shale & Shells
	3116	Lime & Shale
	3185	Lime
	3279	Lime & Shale
	3315	Brown Lime
	3585	Lime
	3614	Lime & Chert
	3650	Lime & Shale
	3662	Shale
	3687	Lime
	3687	Total Depth

The undersigned, Richard Hindery, one of the partners of Birmingham-Bartlett Drilling Co., hereby certifies that the above is a true and correct log of the formations encountered in drilling the Voigt "B" #1 Well as shown in the daily drilling reports.

BIRMINGHAM-BARLETT DRILLING CO.

By

Richard Hindery

Subscribed and sworn to before me
this 24th day of June, 1957

Vivian F. Yinger
Vivian F. Yinger, Notary Public

RECEIVED
STATE CORPORATION COMMISSION

JUL 17 1957

My commission expires November 29, 1958.

CONSERVATION DIVISION
Wichita, Kansas
PLUGGING
FILE SEC. 11 T. 22 R. 12W
BOOK PAGE 22 LINE 35